

21
SECTION

14
TOWN

07
RANGE

ADAMS COUNTY

COUNTY CORNER NO: 86

ROMPORTOL ID: 41407210020

PUBLIC LAND SURVEY MONUMENT RECORD

TYPE OF MONUMENT: HARRISON (BROKEN-TOP)

ADAMS COUNTY COORDINATES, NAD 83 (2007)

N. 111464.947

E. 570477.596


ELEVATION- - - - - DATUM - - - - -

FIELD WORK DATE: 04/23/2020

BASIS FOR MONUMENT LOCATION

1980 - PLS 1478 SET HARRISON MONUMENT EQUIDISTANT AND ON LINE BETWEEN ADJACENT SECTION CORNERS. NO EXCAVATION WAS MADE DUE TO CUT AREA IN TOWN ROAD. NO EVIDENCE OF A BEARING TREE RECORDED IN FIELD BOOK 2 (OLD FIELD BOOKS IN ADAMS COUNTY SURVEYOR'S OFFICE) PAGE 152 BY M. LATHROP WAS FOUND.

2020 - PLS 2675 FOUND HARRISON (BROKEN-TOP) 4"± BELOW THE ROAD SURFACE AND 3 WITNESSES THE MONUMENT AGREES WITH ALL 3 WITNESSES AND IS ON A NEAR STRAIGHT LINE AND EQUIDISTANT SPLIT FROM THE SW AND SE CORNERS OF SECTION 21. ACCEPTED THE HARRISON (BROKEN-TOP) AS THE CORNER LOCATION. SET 4 NEW TIES AND MEASURED TO THE EXISTING WITNESSES.

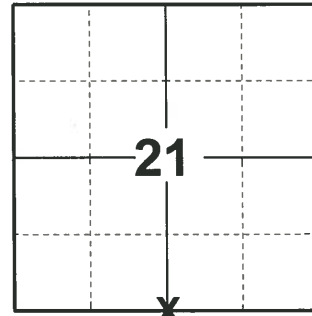

LOCATION
(INDICATE CORNER BY "X")

SEAL:





DATA SHOWN HERE ON THIS TIE SHEET IS CORRECT AND COMPLETE TO THE BEST OF MY KNOWLEDGE AND BELIEF.

PROFESSIONAL LAND SURVEYOR

DATE 5/28/2020

- TIE SKETCH

NOTE: THE CORNER LANDS 3.9"± NORTH OF GOLDEN AVE. CENTERLINE.

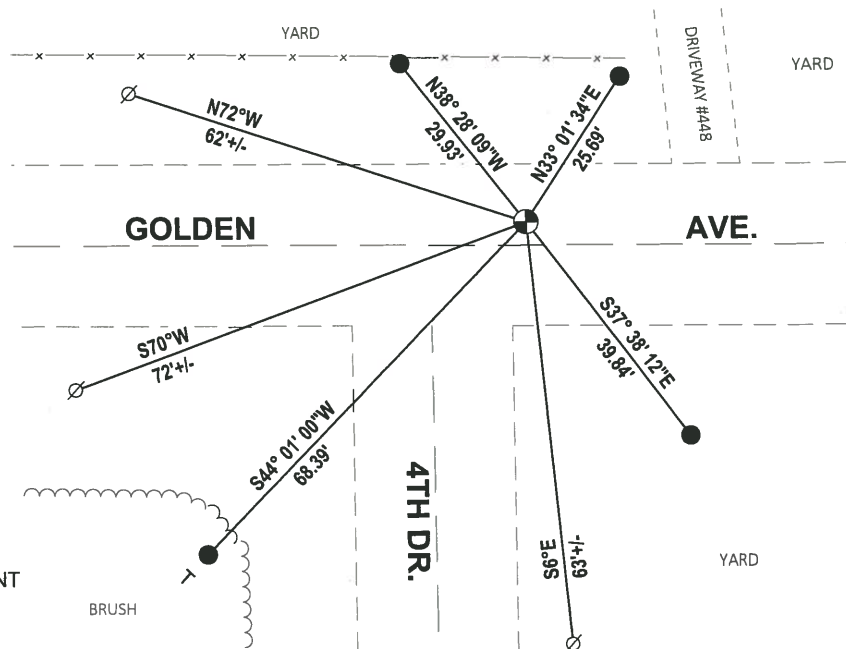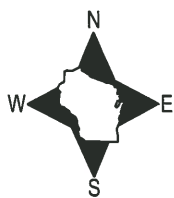

- SET 3/4" x 18" IRON REBAR, 1.50#/FT
- ⊙ FOUND HARRISON (BROKEN-TOP) MONUMENT
- ⊘ WITNESS POWER POLE
- VINYL "T" POST

Government Land Corner Certificate

ADAMS County

TYPE OF MONUMENT: HARRISON

STATE PLANE COORDINATES: N _____

E _____


ELEVATION — M.S.L. DATUM: _____

THETA ANGLE: _____

FIELD BOOK: A.F. 2 PAGE 105

DRAWN BY: S. SORENSEN

CORNER NO. 86
SECTION 21
TOWN 14
RANGE 7

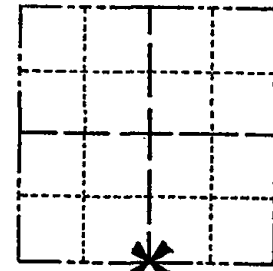

LOCATION
(Indicated by 'X')

BASIS FOR MONUMENT LOCATION

Show info such as: History of corner, with reference to Vol. and pg., dates, surveyor; exact description of monument replaced; if location computed, by taped or EDM traverse; landowner remarks, etc. (Use reverse side if necessary)

Set harrison monument equidistant and on line between adjacent section corners. No excavation was made due to cut area in town road. No evidence of a B.T. recorded in F.B. 2 (old field books in Adams County Surveyor's office) page 152 by M.Lathrop was found.

SEAL:



DATA SHOWN HERE ON
CERTIFIED CORRECT:

Gregory P. Rhinehart
Registered Land Surveyor


DATE: 10-24-80

TIE SKETCH

Show at least four ties, also fence lines, roads, topo, size and type of witness trees and if off road - best way to arrive at corner.

NOTE: TREES ARE NOT BLAZED

NOTE: ties are to nail and disc

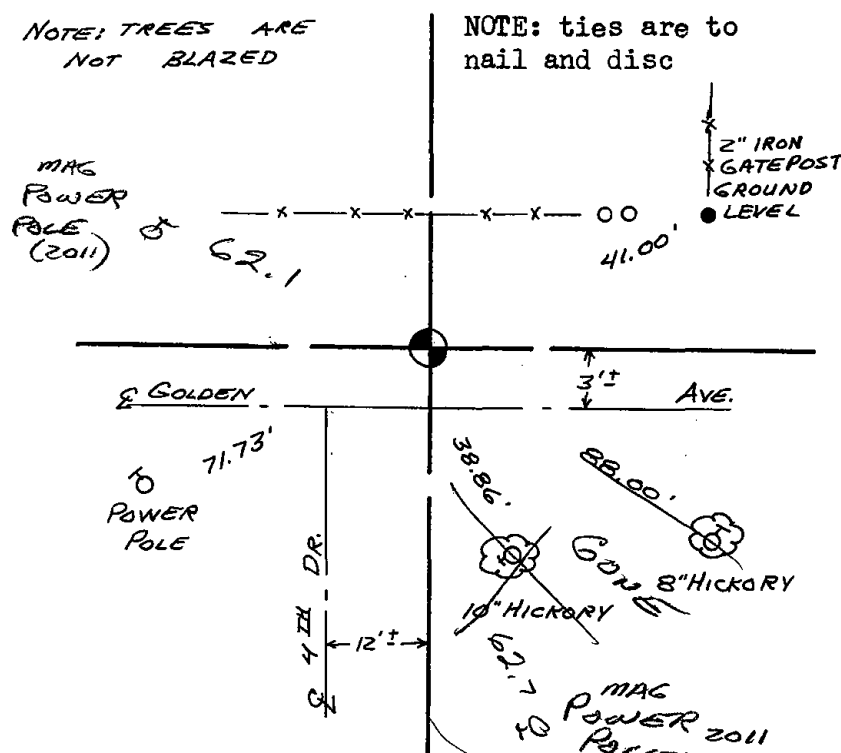

MAINTENANCE RECORD

Date	Init.	Remarks
12-11-81	SK-DW	CORNER O.K.
2-19-86	GR-S	OK
12-19-90	JG-KZ	OK
12-1-95	SS	" TOP BROKEN
6-11-01	JG	OK
2-7-06	JG	OK
2-16-11	SS	2 NEW TIES