

PUBLIC LAND SURVEY MONUMENT RECORD

TYPE OF MONUMENT: HARRISON
ADAMS COUNTY COORDINATES, NAD 83 (2007)

N. 108877.320

E. 562516.768


ELEVATION- DATUM

FIELD WORK DATE: 05/05/2020

BASIS FOR MONUMENT LOCATION


1979 - PLS 922 RESEARCHED ADAMS COUNTY SURVEY RECORDS AND COULD FIND NO RECORD OF ANY OLD RESURVEYS. ALL ORIGINAL EVIDENCE OF THIS CORNER IS LOST. RE-SET THIS CORNER BY THE SINGLE PROPORTIONATE METHOD.

2020 - PLS 2675 FOUND HARRISON 3'± ABOVE THE GROUND AND DID NOT RECOVER ANY EXISTING TIES OR WITNESSES. MONUMENT CHECKED TO BE ON A NEAR STRAIGHT LINE AND EQUIDISTANT BETWEEN ADJACENT SECTION CORNERS. ACCEPTED THE HARRISON AS THE BEST EVIDENCE OF THE CORNER LOCATION AND SET 4 NEW TIES.

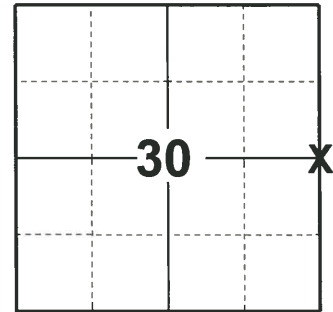

LOCATION
(INDICATE CORNER BY "X")

SEAL:

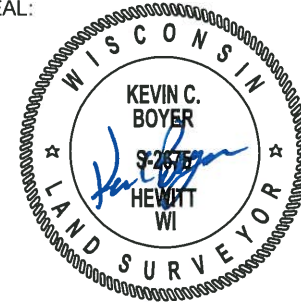


DATA SHOWN HERE ON THIS TIE SHEET IS CORRECT AND COMPLETE TO THE BEST OF MY KNOWLEDGE AND BELIEF.

PROFESSIONAL LAND SURVEYOR

DATE 5/28/2020

- TIE SKETCH

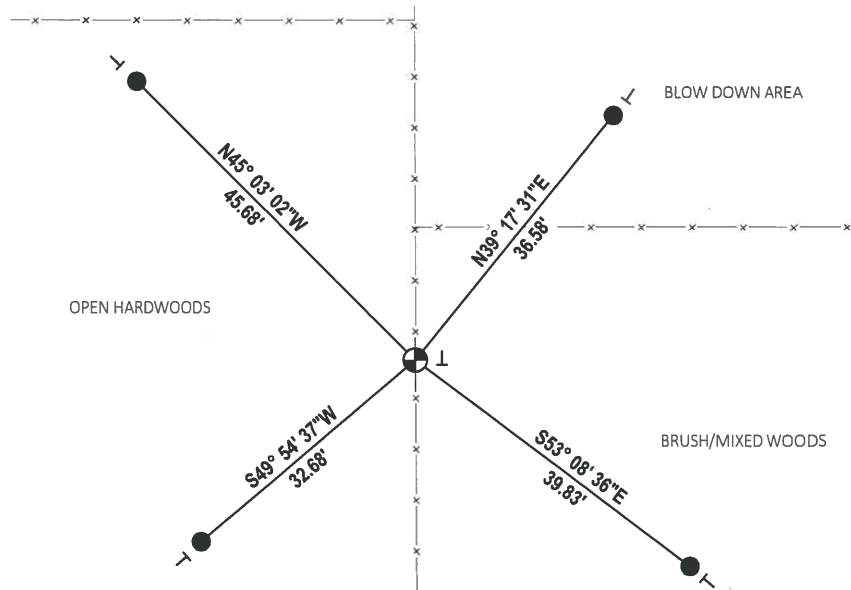

- SET 3/4" x 18" IRON REBAR, 1.50#/FT
- ⊙ FOUND HARRISON MONUMENT
- ┊ VINYL "T" POST

Government Land Corner Certificate

ADAMS County

TYPE OF MONUMENT: STANDARD HARRISON

STATE PLANE COORDINATES: N _____

E _____


ELEVATION — M.S.L. DATUM: _____

THETA ANGLE: _____

FIELD BOOK: _____ PAGE _____

DRAWN BY: Squires

CORNER NO. 95
SECTION 30
TOWN 14-N
RANGE 7-E

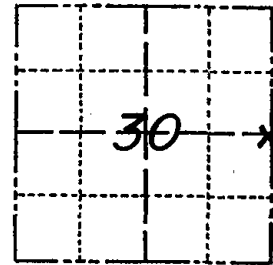


LOCATION
(Indicated by 'X')

BASIS FOR MONUMENT LOCATION

Show info such as: History of corner, with reference to Vol. and pg., dates, surveyor; exact description of monument replaced; if location computed, by taped or EDM traverse; landowner remarks, etc. (Use reverse side if necessary)

RESEARCHED ADAMS COUNTY SURVEY RECORDS & COULD FIND NO RECORD OF ANY OLD RESURVEYS, ALL ORIGINAL EVIDENCES OF THIS CORNER IS LOST. RE-SET THIS CORNER BY THE SINGLE PROPORTIONATE METHOD

SEAL:

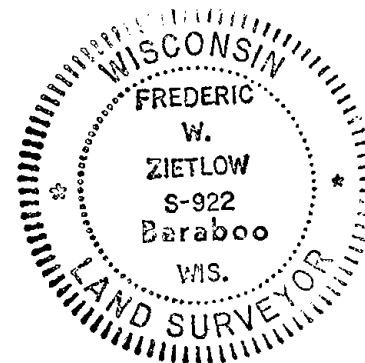


DATA SHOWN HERE ON CERTIFIED CORRECT:

Frederic W. Zietlow
Registered Land Surveyor

DATE: 10-4-79

TIE SKETCH

Show at least four ties, also fence lines, roads, topo, size and type of witness trees and if off road - best way to arrive at corner.

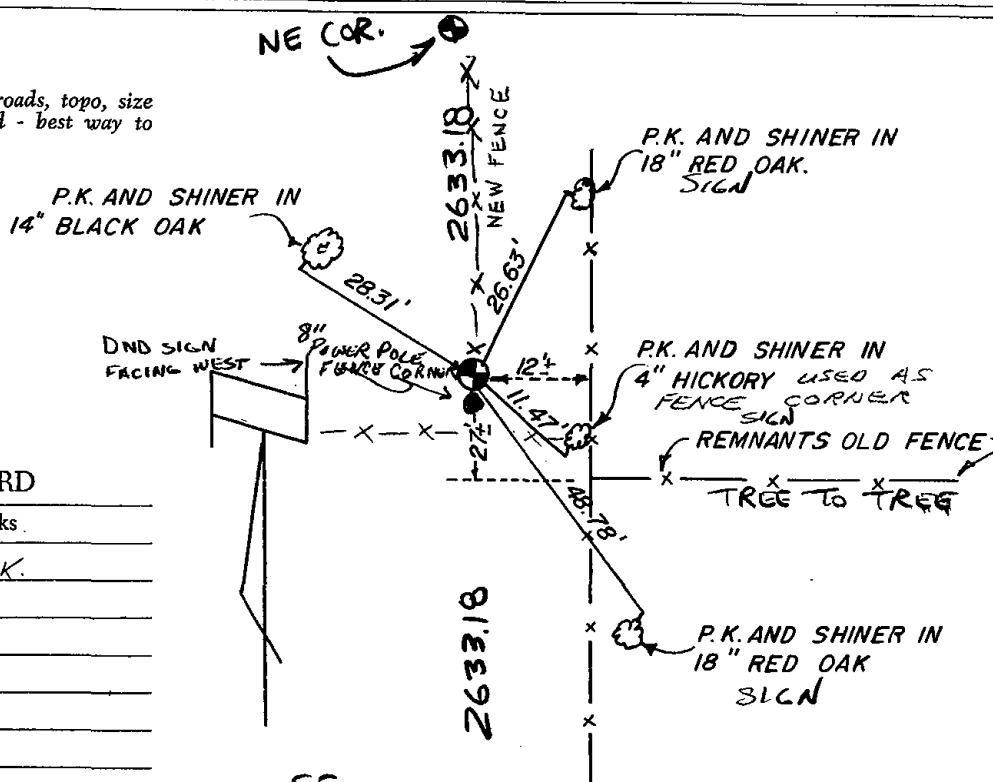

MAINTENANCE RECORD

Date	Init.	Remarks
12-11-81	SK-DW	CORNER O.K.
3-19-86	GR-SS	" "
8-5-91	JG	" "
12-19-01	JG-JS	" "
1-24-06	JG	OK
1-5-12	MS	OK