SECTION

# OS ADAMS COUNTY

COUNTY CORNER NO: 20

ROMPORTOL ID: 41505012000

### PUBLIC LAND SURVEY MONUMENT RECORD

TYPE OF MONUMENT:

**SURVEY NAIL** 

ADAMS COUNTY COORDINATES, NAD 83 (2007)

N. **161973.945** 

E. 525862.073

**ELEVATION-**

DATUM


FIELD WORK DATE:

10/09/2017


### BASIS FOR MONUMENT LOCATION

2013 - PLS 1452 SET LOCATION FROM OCT 31, 1980 TIE SHEET AND SECTION SUMMARY DISTANCE TO THE SOUTH. SET A BERNTSEN SURVEY NAIL AT THE CORNER LOCATION AND RE-TIED.

2017 - PLS 2994 FOUND A SURVEY NAIL IN THE ROAD SURFACE, 1 PROPERTY IRON AND 4 TIES. REMOVED THE SURVEY NAIL AND SEARCHED FOR A MONUMENT BELOW IT, FOUND NO EVIDENCE OF ANY MONUMENT. RE-SET THE SURVEY NAIL IN THE LOCATION THAT IT WAS FOUND. THE MONUMENT AGREES WITH THE TIES. ACCEPTED THE SURVEY NAIL AS THE CORNER LOCATION AND RE-MEASURED TO THE EXISTING PROPERTY IRON AND TIES.

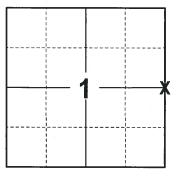

LOCATION (INDICATE CORNER BY "X")

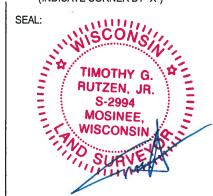

DATA SHOWN HERE ON THIS TIE SHEET IS CORRECT AND COMPLETE TO THE BEST OF MY KNOWLEDGE AND BELIEF


PROFESSIONAL LAND SURVEYOR

DATE 12-4-17

#### - TIE SKETCH

NOTE: THE CORNER FALLS 11'± WEST OF THE CENTERLINE OF STH 13.



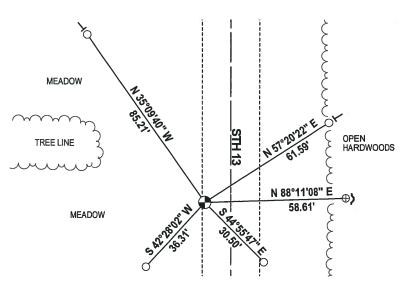

WISDOT ALUMINUM BERNTSEN MONUMENT FOUND

## 3/4" IRON ROD FOUND

SURVEY NAIL FOUND ✓ STEEL FENCE POST

→ VINYL "T" POST

## ADAMS COUNTY U.S. PUBLIC LAND SURVEY CORNER # MONUMENT LOCATION RECORD FOUND X SET TOWNSHIP NORTH EAST RE-SET SECTION 1 X RE-TIED X LANDMARK BENCHMARK CORNER IDENTITY BERNTSEN SURVEY NAIL SET COUNTY COORDINATES: N. 161,973.97 E. 525,862.00 ELEVATION \_\_\_\_ WEATHER DATE OF SURVEY June 23, 2013 SURVEY PARTY \_\_ Dennis J. Christie, RLS BASIS FOR MONUMENT LOCATION: (DESCRIBE METHOD OF SURVEY AND CORNER AUTHENTICATION ) SET LOCATION FROM OCT 31,1980 TIE SHEET AND SECTION SUMMARY DISTANCE TO SOUTH. SHOW MINIMUM OF FOUR (4) HORIZONTAL TIE DISTANCES TO FIXED WITNESS MONUMENTS. TIE SKETCH: DESCRIBE ALL MONUMENTS FOUND OR SET. DRAWING IS NOT TO SCALE. LEGEND BERNTSEN SURVEY NAIL SET BERNTSEN MONUMENT A2BR30 SET

46.23 S83° 37'42''W