O5 ADAMS COUNTY COUNTY

PUBLIC LAND SURVEY MONUMENT RECORD

TYPE OF MONUMENT:

2-3/8" O.D. IRON PIPE

ADAMS COUNTY COORDINATES, NAD 83 (2007)

N. 148764.646

E. 520785.441

DATUM

FIELD WORK DATE: 07/27/2018


BASIS FOR MONUMENT LOCATION

1983 - PLS 1478 SET MONUMENT AT THE RECORD ORIGINAL DISTANCE WEST OF THE SOUTH QUARTER CORNER OF SECTION 13 AND ON AN EXTENSION OF THE SOUTH LINE OF THE SOUTHEAST QUARTER OF SECTION 13. DILIGENT SEARCH IN THIS AREA YIELDED NO EVIDENCE OF EITHER THE ORIGINAL MONUMENT, BEARING TREES, MONUMENTS PLACED BY ZENUS WISE, ADAMS COUNTY SURVEYOR 1870-1878, IN HIS SURVEY OF AUGUST 1876, OR ANY SIGNS IF POSSESSION. SET A 1-1/4" X 30" REBAR AT THE CORNER LOCATION AND TIED OUT.

2018 - PLS 2675 FOUND A 2-3/8" O.D. IRON PIPE 4" ABOVE THE GROUND SURFACE AND 2 WITNESS TREES. FOUND NO EVIDENCE OF THE 1-1/4" IRON ROD, IT IS BELIEVE THAT THE CORNER WAS SET FROM CSM 3634. SET 4 NEW TIES AND MEASURED TO THE TIES AND WITNESS TREES TO THE ORIGINAL MONUMENT.



(INDICATE CORNER BY "X")

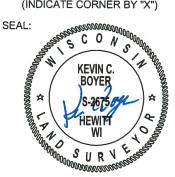

DATA SHOWN HERE ON THIS TIE SHEET IS CORRECT AND COMPLETE TO THE BEST OF MY KNOWLEDGE AND BELIEF.


PROFESSIONAL LAND SURVEYOR

-TIE SKETCH

NOTE: THE CORNER FALLS 19'± EAST OF THE EDGE OF THE WISCONSIN RIVER.



- SET 3/4" x 18" IRON REBAR, 1.50#/FT
- FOUND 2-3/8" O.D. IRON PIPE
- VINYL "T" POST
- WITNESS TREE

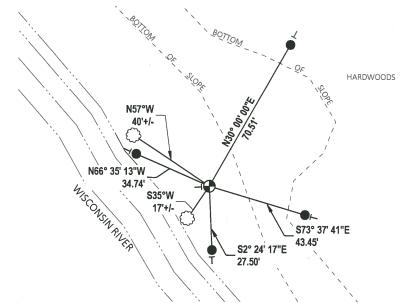

Government Land Corner Certificate corner no. 21 4 **ADAMS** County 13 M.C. 16 SECTION TYPE OF MONUMENT: 15" X 30" Rebar 15 TOWN STATE PLANE COORDINATES: RANGE ELEVATION - M.S.L. DATUM: _ THETA ANGLE: . FIELD BOOK: Loose Keaf _ PAGE . DRAWN BY: S. Sorensen BASIS FOR MONUMENT LOCATION Show info such as: History of corner, with reference to Vol. M.C. 16 and pg., dates, surveyor; exact description of monument replaced; if location computed, by taped or EDM traverse; LOCATION landowner remarks, etc. (Use reverse side if necessary) (Indicated by 'X') SEAL: Set monument at the record original distance west of the South Quarter corner of section 13 and on an extension of the south line of the Southeast Quarter of section 13. Diligent search RHINEHARI inthis area yeilded no evidence of either the S-1478 original monument, bearing trees, monuments placed by Zenus Wise, adams County Surveyor 1870-1878, in his survey of August 1876, or any signs of possesion. DATA SHOWN HERE ON CERTIFIED CORRECT: Registered VOLE 1983 DATE: 1/4" IRON ROD TIE SKETCH MEANDER CORNER Show at least four ties, also fence lines, roads, topo, size and type of witness trees' and if off road - best way to CH 15" MAPLE arrive at corner. CORNER IS 38 FROM 6"MAPLE ±s 86° W 11.95 MAINTENANCE RECORD Remarks Date Init.

14" MAPLE

1/14/2014

OK

61