

36
SECTION

16
TOWN

06
RANGE

ADAMS COUNTY

COUNTY CORNER NO: 133

ROMPORTOL ID: 41606360000

PUBLIC LAND SURVEY MONUMENT RECORD

TYPE OF MONUMENT: HARRISON
ADAMS COUNTY COORDINATES, NAD 83 (2007)

N. 164701.561

E. 557753.355

ELEVATION- DATUM


FIELD WORK DATE: 09/20/2017

BASIS FOR MONUMENT LOCATION

1972 - PLS 981 FOUND A PK NAIL AT CORNER LOCATION. REPLACED PK NAIL WITH A 30" HARRISON MONUMENT AND TIED OUT.


1999- PLS 2281 FOUND AND RE-SET HARRISON MONUMENT AFTER THE COMPLETION OF COUNTY HIGHWAY B RECONSTRUCTION PROJECT. CORNER LOCATION IS BASED ON THE EXISTING MONUMENT FOUND BEFORE CONSTRUCTION BEGAN. RE-TIED CORNER.

2017 - PLS 2994 FOUND A HARRISON MONUMENT 6" BELOW THE ROAD SURFACE AND 4 TIES. THE MONUMENT AGREES WITH THE EXISTING TIES. ACCEPTED THE HARRISON MONUMENT AS THE CORNER LOCATION RE-MEASURED TO THE EXISTING TIES.

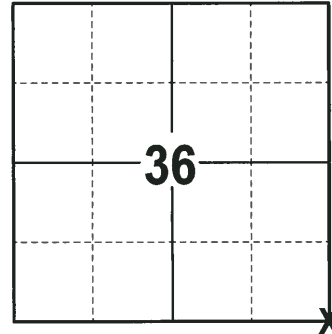

LOCATION
(INDICATE CORNER BY "X")

SEAL:

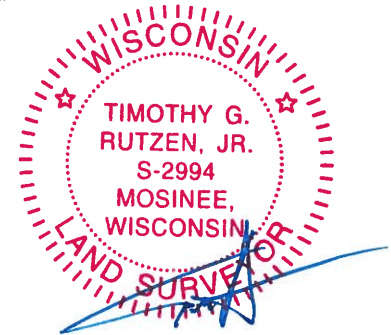



DATA SHOWN HERE ON THIS TIE SHEET IS CORRECT AND COMPLETE TO THE BEST OF MY KNOWLEDGE AND BELIEF.

PROFESSIONAL LAND SURVEYOR

DATE 12-4-17

- TIE SKETCH -

NOTE: THE CORNER FALLS 2± NORTH OF THE CENTERLINE OF FAWN AVE.

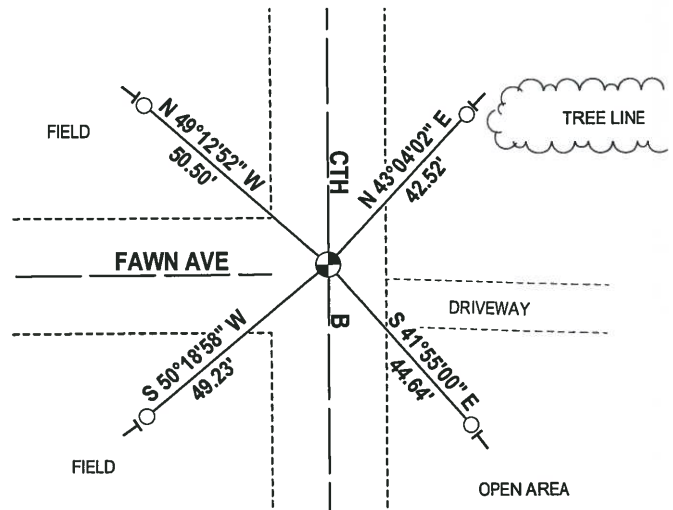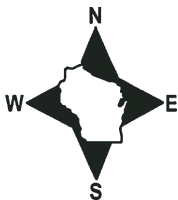


- 1-1/4" O.D. IROD PIPE FOUND
- ⊕ HARRISON FOUND
- ⊢ VINYL "T" POST

ADAMS COUNTY

Survey Monument Record

TYPE OF MONUMENT: 30" HARRISON
STATE PLANE COORDINATES: N _____
E _____
ELEVATION — M.S.L. DATUM: _____
THETA ANGLE: _____
FIELD BOOK: 103 PAGE 131

CORNER NO. 131
SECTION 1
TOWN 15
RANGE 6

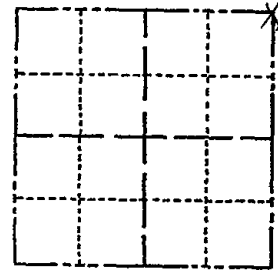

LOCATION
(Indicated by 'X')

SEAL:

BASIS FOR MONUMENT LOCATION

(Use reverse side if necessary)

Show info such as: History of corner, with reference to Vol. and pg, dates, surveyor; exact description of monument replaced; if location computed, by taped or EDM traverse; landowner remarks, etc.

Found "PK" nail and set 30" Harrison monument on May 17, 1972

Sam T. Mullen R.L.S. 981

CORNER	O.K.	4-23-76	RN-SS
"	"	1-16-86	GR-SS
"	"	1-31-91	KZ-JG
"	"	11-22-95	SS

SEE ATTACHED SHEET, GROHOLSKI, 12/21/99
2-6-01 - JG OK, SEE ATTACHED SHEET
3-13-06 JB-SS OK "
12-21-11 ML 1 NEW

CERTIFIED CORRECT:

Registered Land Surveyor

DATE: _____

TIE SKETCH

(Show at least four ties)

