

## PUBLIC LAND SURVEY MONUMENT RECORD

TYPE OF MONUMENT: HARRISON  
ADAMS COUNTY COORDINATES, NAD 83 (2007)

N. 159503.406

E. 549733.871


ELEVATION- - - - DATUM - - - -

FIELD WORK DATE: 06/14/2018

### BASIS FOR MONUMENT LOCATION

1980 (APPROX) - PLS 1478 EXCAVATED WITH A BACKHOE AND FOUND A STAIN FROM A DRIVEN WOOD POST. THIS LOCATION "FITS" THE SECTION VERY WELL. SET A HARRISON MONUMENT AND TIED OUT.

2018 - PLS 2994 FOUND A HARRISON MONUMENT 3" BELOW THE GROUND SURFACE, 1 PROPERTY IRON (USED AS A TIE) AND 1 WITNESS. THE MONUMENT AGREES WITH THE EXISTING WITNESS. ACCEPTED THE HARRISON MONUMENT AS THE CORNER LOCATION. SET 3 NEW TIES AND MEASURED TO THE TIES AND WITNESS.

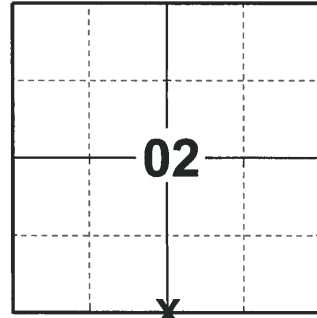

**LOCATION**

(INDICATE CORNER BY "X")

SEAL:




DATA SHOWN HERE ON THIS TIE SHEET IS CORRECT AND COMPLETE TO THE BEST OF MY KNOWLEDGE AND BELIEF.

PROFESSIONAL LAND SURVEYOR


DATE 7-18-18

### - TIE SKETCH

NOTE: THE CORNER FALLS 45'± WEST OF THE CENTERLINE OF 8TH DR/FERN AVE.

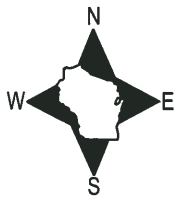


- SET 3/4" x 18" IRON REBAR, 1.50#/FT
- ⊙ FOUND 5/8" IRON ROD
- ⊕ FOUND HARRISON MONUMENT
- ⊗ WITNESS POWER POLE
- ↙ STEEL FENCE POST
- VINYL "T" POST
- ⊠ STREET SIGN

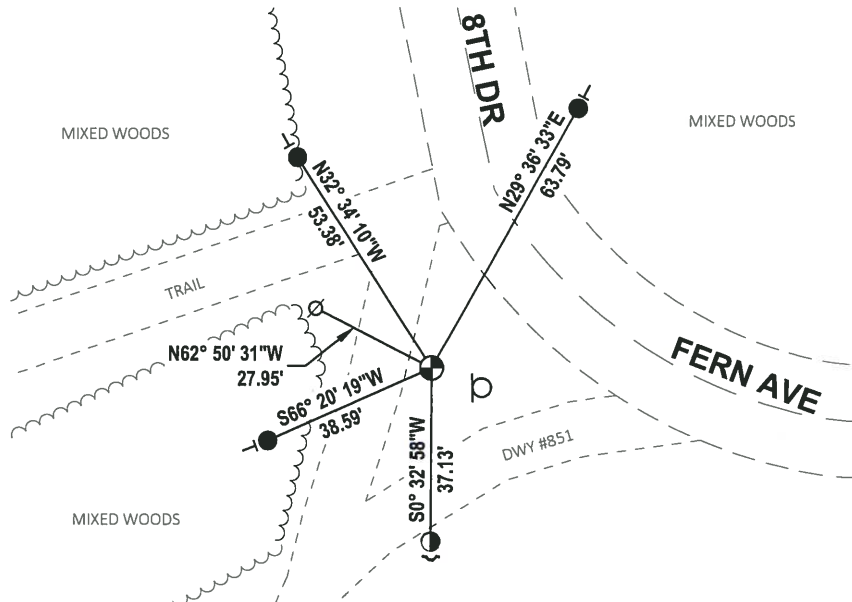

# Government Land Corner Certificate

ADAMS County  
 TYPE OF MONUMENT: HARRISON  
 STATE PLANE COORDINATES: N \_\_\_\_\_  
 E \_\_\_\_\_  
 ELEVATION — M.S.L. DATUM: \_\_\_\_\_  
 THETA ANGLE: \_\_\_\_\_  
 FIELD BOOK: 78 PAGE 132  
 DRAWN BY: R. NUBER

CORNER NO. 30  
 SECTION 2  
 TOWN 15  
 RANGE 6

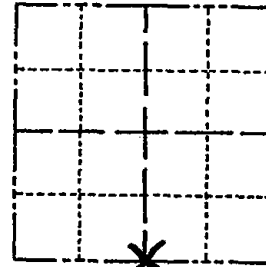

LOCATION  
 (Indicated by 'X')

## BASIS FOR MONUMENT LOCATION

Show info such as: History of corner, with reference to Vol. and pg., dates, surveyor; exact description of monument replaced; if location computed, by taped or EDM traverse; landowner remarks, etc. (Use reverse side if necessary)

Excavated with backhoe and found stain from driven wood post. This location "fits" the section very well.

## MAINTENANCE RECORD

Date	Init.	Remarks
12-30-81	SK-RW	CORNER O.K.
1-16-86	GD-SS	1 NEW TIE
1-14-91	KE-JG	ALL OK
11-22-95	SS	OK
1-29-01	JG-MH	OK
4-28-06	JG	OK
7-11-11	SS	2 NEW

SEAL:



DATA SHOWN HERE ON  
 CERTIFIED CORRECT:

*Gregory P. Rhinehart*  
 Registered Land Surveyor

DATE: \_\_\_\_\_

## TIE SKETCH

Show at least four ties, also fence lines, roads, topo, size and type of witness trees' and if off road - best way to arrive at corner.



