

PUBLIC LAND SURVEY MONUMENT RECORD

TYPE OF MONUMENT: HARRISON
ADAMS COUNTY COORDINATES, NAD 83 (2007)

N. 154006.420

E. 539181.715


ELEVATION- - - - DATUM - - - -

FIELD WORK DATE: 06/19/2018

BASIS FOR MONUMENT LOCATION

1975 - PLS 1103 FOUND A 24"x18" SANDSTONE AT THE FENCE CORNER. HAND EXCAVATION REVEALED CHARCOAL BITS IN THE EXCAVATION LOCATION. STONE HAD A FAINT CHISEL CROSS ON TOP. ACCEPTED STONE AS CORNER AND TIED OUT.


2018 - PLS 2994 FOUND A HARRISON MONUMENT 12" BELOW THE ROAD SURFACE AND 1 TIE. NO RECORD OF WHEN THE HARRISON MONUMENT WAS SET. THE MONUMENT AGREES WITH THE EXISTING TIE, WHICH AGREES WITH PRIOR LOCATION OF STONE. ACCEPTED THE HARRISON MONUMENT AS THE CORNER LOCATION. SET 3 NEW TIES AND MEASURED TO THE TIES.

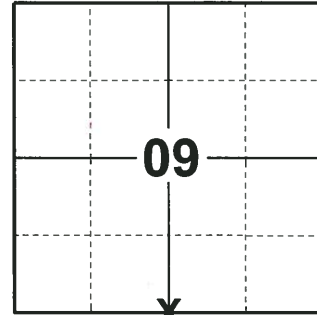

LOCATION

(INDICATE CORNER BY "X")

SEAL:


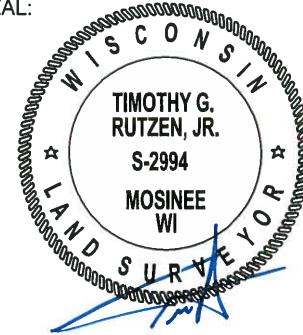


DATA SHOWN HERE ON THIS TIE SHEET IS CORRECT AND COMPLETE TO THE BEST OF MY KNOWLEDGE AND BELIEF.

PROFESSIONAL LAND SURVEYOR

DATE 8-10-18

- TIE SKETCH

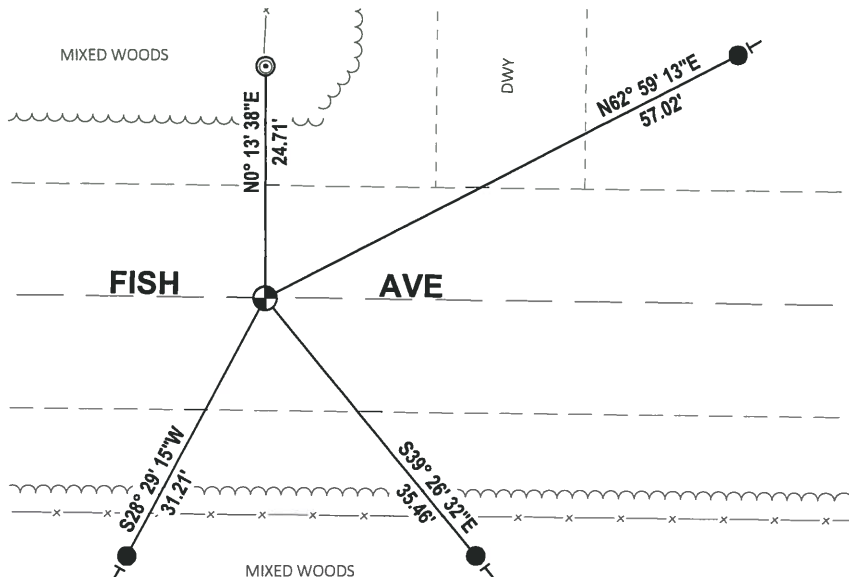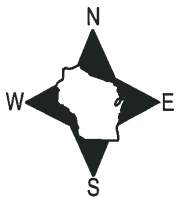


- SET 3/4" x 18" IRON REBAR, 1.50#/FT
- ⊙ FOUND 2-3/8" O.D. IRON PIPE
- ⊕ FOUND HARRISON MONUMENT
- | VINYL "T" POST

ADAMS COUNTY

Survey Monument Record

TYPE OF MONUMENT: STONE with chisel cross
 STATE PLANE COORDINATES: N _____
 E _____
 ELEVATION — M.S.L. DATUM: _____
 THETA ANGLE: _____
 FIELD BOOK: _____ PAGE _____

CORNER NO. 719
 SECTION 9
 TOWN 15
 RANGE 6

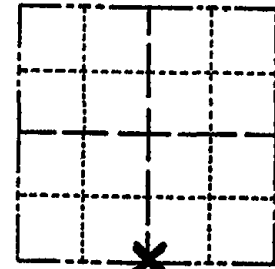

LOCATION
(Indicated by 'X')

SEAL:

BASIS FOR MONUMENT LOCATION

(Use reverse side if necessary)


Show info such as: History of corner, with reference to Vol. and pg. dates, surveyor; exact description of monument replaced; if location computed, by taped or EDM traverse; landowner remarks, etc.

Found 24"X18" Sandstone at Fence Corner.
 Hand excavation revealed charcoal bits in dug in pit. Stone had faint chisel cross on top.

CORNER O.K. 9-25-76 RN-SS

MAINTENANCE RECORD

Date	Init.	Remarks
12-28-81	SK-RW	Mon + Jss O.K.
1-21-86	GR-SS	OK
10-30-90	^{REN} CARLSON	OK
1-31-91	KZ-SG	ALL OK
11-21-99	SS	OK
1-25-01	JG	OK
3-07-06	JS-SS	"
1-24-11	SS	OK

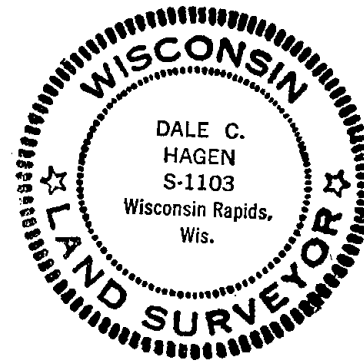


CERTIFIED CORRECT:

Dale C. Hagen
 Registered Land Surveyor

DATE: 4/23/75

TIE SKETCH

(Show at least four ties)

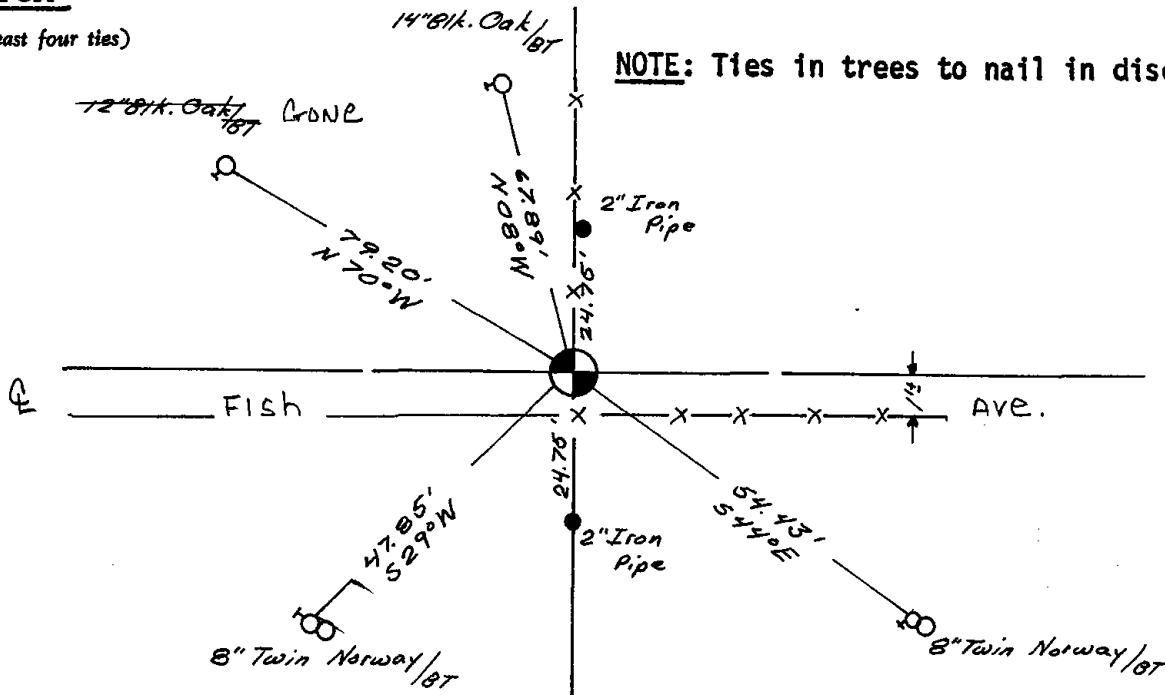

NOTE: Ties in trees to nail in disc.

