

## PUBLIC LAND SURVEY MONUMENT RECORD

TYPE OF MONUMENT: HARRISON (BROKEN-TOP)  
 ADAMS COUNTY COORDINATES, NAD 83 (2007)

N. 138205.618

E. 536526.629


ELEVATION-      DATUM     

FIELD WORK DATE: 07/11/2018

### BASIS FOR MONUMENT LOCATION


1973 - PLS 878 EXCAVATED WITH A BACKHOE AND FOUND A 8" x 8" x 30" CUT SANDSTONE. WITNESSED BY LOCAL LANDOWNER CLARK ELDERKIN. STONE SET BY BARRETT PER COUNTY SURVEYOR RECORDS. LOWERED STONE AND SET HARRISON ON TOP AND TIED OUT CORNER.

2018 - PLS 2994 FOUND A HARRISON MONUMENT WITH A BROKEN-TOP 8" BELOW THE ROAD SURFACE AND 2 WITNESSES. THE MONUMENT AGREES WITH THE EXISTING WITNESSES. ACCEPTED THE HARRISON MONUMENT WITH A BROKEN-TOP AS THE CORNER LOCATION. SET 4 NEW TIES AND MEASURED TO THE TIES AND WITNESSES.

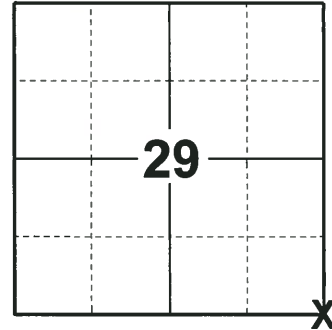

**LOCATION**  
 (INDICATE CORNER BY "X")

SEAL:

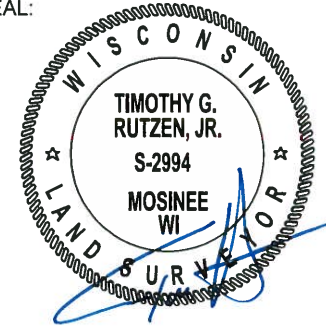



DATA SHOWN HERE ON THIS TIE SHEET IS CORRECT AND COMPLETE TO THE BEST OF MY KNOWLEDGE AND BELIEF.

PROFESSIONAL LAND SURVEYOR

DATE 8-16-18

### - TIE SKETCH

NOTE: THE CORNER FALLS 3 1/2 WEST OF THE CENTERLINE OF 11TH AVE.

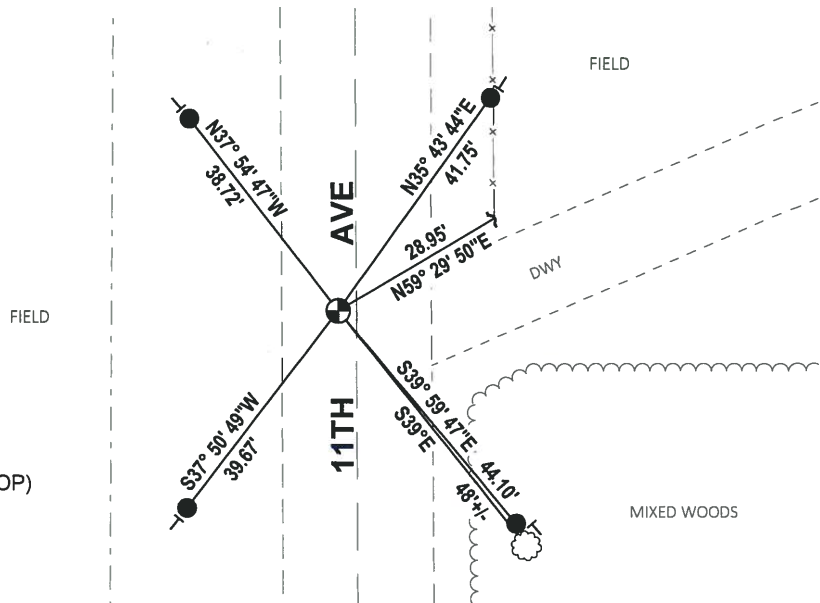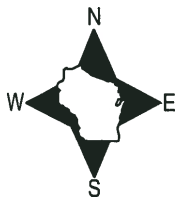


- SET 3/4" x 18" IRON REBAR, 1.50#/FT
- ⊕ FOUND HARRISON MONUMENT (BROKEN-TOP)
- ↗ WITNESS ANGLE IRON FENCE POST
- VINYL "T" POST
- ☁ WITNESS TREE

# ADAMS COUNTY

## Survey Monument Record

TYPE OF MONUMENT: 30" HARRISON  
 STATE PLANE COORDINATES: N \_\_\_\_\_  
 E \_\_\_\_\_  
 ELEVATION — M.S.L. DATUM: \_\_\_\_\_  
 THETA ANGLE: \_\_\_\_\_  
 FIELD BOOK: \_\_\_\_\_ PAGE \_\_\_\_\_

CORNER NO. 341  
 SECTION 28  
 TOWN 15  
 RANGE 6

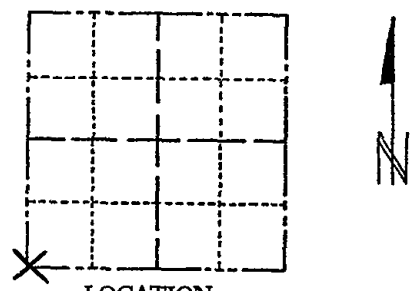

LOCATION  
(Indicated by 'X')

### BASIS FOR MONUMENT LOCATION

(Use reverse side if necessary)

Show info such as: History of corner, with reference to Vol. and pg. dates, surveyor; exact description of monument replaced; if location computed, by taped or EDM traverse; landowner remarks, etc.

Excavated with backhoe. Found 8" x 8" x 30" cut sandstone. Witnessed by local landowner Clark Elderkin. Stone set by Barrett per county surveyor records. Lowered stone and set Harrison on top.

CORNER O.K. 10-14-76 JS-SS

SEAL:



### MAINTENANCE RECORD

Date	Init.	Remarks
12-28-81	SK-BM	ADDED P. O.K.
1-16-86	GR-SS	" 1 TIE GONE - NOTHING FOUND.
1-31-91	KZ-JG	ALL OK
1-16-96	JG-SS	OK
2-6-01	JG	OK
5-12-06	JG	OK
7-08-11	SS	OK

CERTIFIED CORRECT:

*Anthony B. Kiedrowski*  
 Registered Land Surveyor

DATE: 9/5/73

### TIE SKETCH

(Show at least four ties)

