# 06 ADAMS COUNTY COUNTY CORNER NO: 119 POMPORTO ID: 415062520

ROMPORTOL ID: 41506352000


## PUBLIC LAND SURVEY MONUMENT RECORD

**HARRISON** TYPE OF MONUMENT: ADAMS COUNTY COORDINATES, NAD 83 (2007) N. **135568.626** E. 552364.107 - — DATUM ELEVATION-07/17/2018 FIELD WORK DATE:


#### BASIS FOR MONUMENT LOCATION

1976 - PLS 922 CHECKED THE ADAMS COUNTY SURVEY RECORDS AND THE LAST RESURVEY WAS IN 1907 BY M.C. SMITH. FOUND NO EVIDENCE OF HIS BEARING TREES OR THE CORNER AFTER EXCAVATING THE SAND ROAD. FOUND A 1/2" x 16" IRON ROD AND ACCEPTED AS THE CORNER (BEST AVAILABLE EVIDENCE). THE LOCATION FIT EDM TRAVERSE OF THE SECTION GOOD. REPLACED THE IRON ROD WITH A HARRISON AND TIED OUT.

2018 - PLS 2994 FOUND A HARRISON MONUMENT 10" BELOW THE ROAD SURFACE AND 1 PROPERTY IRON. ACCEPTED THE HARRISON MONUMENT AS THE BEST EVIDENCE OF THE CORNER LOCATION. SET 3 NEW TIES AND MEASURED TO THE TIES AND PROPERTY IRON.

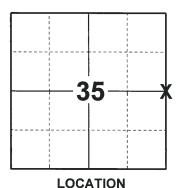

(INDICATE CORNER BY "X")

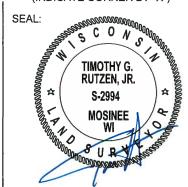

DATA SHOWN HERE ON THIS TIE SHEET IS CORRECT AND COMPLETE TO THE BEST OF MY KNOWLEDGE AND BELIEF.

PROFESSIONAL LAND SURVEYOR

8-10-18 DATE


### - TIE SKETCH

NOTE: THE CORNER FALLS 3'± WEST OF THE CENTERLINE OF 8TH AVE.



- SET 3/4" x 18" IRON REBAR, 1.50#/FT
- FOUND 3/4" IRON ROD
- FOUND HARRISON MONUMENT

VINYL "T" POST

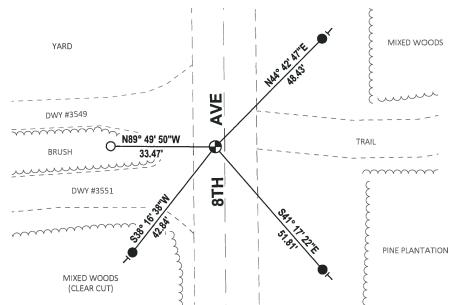

#### ADAMS COUNTY CORNER NO. 35 SECTION Survey Monument Record 15 N TOWN TYPE OF MONUMENT: 30" HARRISON 6E RANGE STATE PLANE COORDINATES: N. E ELEVATION - M.S.L. DATUM: \_ THETA ANGLE: \_\_ FIELD BOOK: \_\_\_\_ \_ PAGE \_ BASIS FOR MONUMENT LOCATION (Use reverse side if necessary) LOCATION Show info such as: History of corner, with reference to Vol. and pg, dates, surveyor; exact description of monument replaced; if location computed, by taped or EDM traverse; landowner (Indicated by 'X') SEAL: remarks, etc. CHECKED ADAMS COUNTY SURVEY RECORDS AND THE LAST RESURVEY WAS IN 1907 BY M.C. SMITH, COULD FIND NO EVIDENCE OF HIS BEARING TREE OR THE CORNER AFTER EXCAUATING THE SAND ROAD. FOUND A Y2"X 16" IRON ROD AND ACCEPTED AS CORNER (BEST AVAILABLE EVIDENCE) FIT EDM TRAVERSE OF SECTION GOOD. CERTIFIED CORRECT: Frederic W. Registered Land Surveyor 5-26-76 DATE: \_ TIE SKETCH SOUTH EDGE No. POST (Show at least four ties) #3549 £00 TOP OF FIRE HYDRANTS HAVE D P.K. NAIL & SHINER BEEN RELOCATEP HOUSE NORTH IN UTILITY POLE FIRE HYDRANT OLD FENCE TREE LINE B"NORWAY (NO TRESP. MAINTENANCE RECORD 5160 Īnit, Date Remarks 12-28-81 SK-BW Mond Ties O.K ZNEW TIES 2-12-91 55-JG ALL OK 1-16-96 56-55 OK 2-6-01 JG ok PK NAIL

14" ASPEN

REVISED 1974

5-12-06

JG