OT ADAMS COUNTY

COUNTY CORNER NO: 131

ROMPORTOL ID: 41607350000


PUBLIC LAND SURVEY MONUMENT RECORD

| | HARRISON |
|---------------------------------|-----------|
| ADAMS COUNTY COORDINATES, NAD 8 | 33 (2007) |
| N. 164770.666 | |
| E583807.657 | |
| ELEVATION DATUM_ | |
| FIELD WORK DATE: 12/13/2017 | |


BASIS FOR MONUMENT LOCATION

1974 - PLS 970 CORNER SET AT THE INTERSECTION OF AN EAST-WEST FENCE LINE AND WHAT APPEARED TO BE THE REMAINS OF AN OLD NORTH-SOUTH FENCE LINE. BIGGING AT THIS LOCATION RECOVERED WHAT APPEARED TO BE AN OLD WOODEN FENCE POST. THIS CORNER WAS INCLUDED IN AN EXTENSIVE E.D.M. TRAVERSE. SET A HARRISON MONUMENT AT THE OLD WOODEN POST LOCATION AND TIED OUT.

2017 - PLS 2994 FOUND A HARRISON MONUMENT FLUSH WITH THE GROUND SURFACE AND 3 PROPERTY IRONS (1 PROPERTY IRON WAS USED AS A TIE). THE MONUMENT AGREES WITH THE EXISTING TIE. ACCEPTED THE HARRISON MONUMENT AS THE CORNER LOCATION. SET 3 NEW TIES AND MEASURED TO THE TIES AND PROPERTY IRONS.

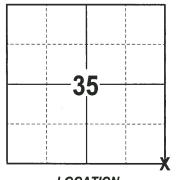

LOCATION (INDICATE CORNER BY "X")

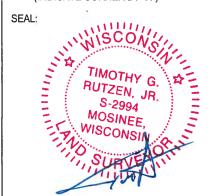

DATA SHOWN HERE ON THIS TIE SHEET IS CORRECT AND COMPLETE TO THE BEST OF MY KNOWLEDGE AND BELIEF.

PROFESSIONAL LAND SURVEYOR

- TIE SKETCH


NOTE: THE CORNER FALLS 42'± WEST OF THE CENTERLINE OF 2ND AVE.



3/4" x 18" IRON REBAR SET, 1.50#/FT

3/4" IRON ROD FOUND THARRISON FOUND

✓ STEEL FENCE POST → VINYL "T" POST

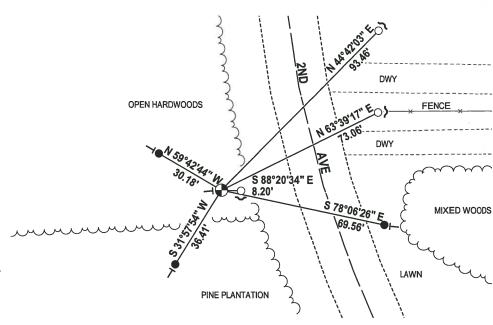

| ADAMS COUNTY | CORNER NO. | |
|-------------------------------------------------------------------------------------------------------------------------------------------------------------------------------------------------------|----------------------------------------------------------------------------------------------|------|
| Survey Monument Record | SECTION | 1 |
| Hammi aan | TOWN | 15 |
| TYPE OF MONUMENT: | RANGE | 7 |
| E | X | |
| ELEVATION — M.S.L. DATUM: | Ţ | 4 |
| FIELD BOOK: S-1063 PAGE | ļ <u>-</u> | 4 |
| FIELD BOOK: S-1063 PAGE | | N |
| | | |
| BASIS FOR MONUMENT LOCATION | | |
| (Use reverse side if necessary) | LOCATION | |
| Show info such as: History of corner, with reference to Vol. and pg, dates, surveyor; exact description of monument replaced; if location computed, by taped or EDM traverse; landowner remarks, etc. | (Indicated by 'X') SEAL: | |
| CORNER SET AT INTERSECTIONS OF AN EAST-WEST FENCE LINE AND WHAT APPEARED TO BE THE REMIANS OF AN OLD NORTH-SOUTH FENCE LINE. | William CONS IN THE | 8. |
| DIGGING AT THIS LOCATION RECOVERED WHAT APPEARED TO BE AN OLD WOODEN FENCE POST. | SEAL: LOCATION (Indicated by X') SEAL: DALE D. RICE S-970 APPLETON, WIS. GP-SS GR-JG | |
| THIS CORNER WAS INCLUDED IN AN EXTENSIVE E.D.M. TRAVERSE. | APPLETON, OF WIS. | 1 |
| Corner & ties O.K trees scribed 87 - 4-1-76 | GR-SS Millian SUR 1985 | |
| 11 4-1-91 | 6R-JG | |
| 1 NEW TIE 3-11-96 55 | CERTIFIED CORRECT: | フ |
| 1- NEW TIE 3-8-06 - JG | Malla Dice | |
| 3-15-11 SE OK | Registered Land Surveyor DATE: 12/13/74 | |
| | | |
| TIE SKETCH | | |
| (Show at least four ties) | | |
| Burk | SEE SURJEY FO | R. |
| PK. IN 6" OAK | ZND AVE SO OF | ۶ 🖣 |
| ∨Q * ' _\ ,, | corner | N |
| * // // // // // // // // // // // // // | , | |
| BURR O. LANGE | 10" CHERRY BT | , , |
| P.K. IN IL"OAK \ \ 1.9' (3) \ | 10 CHERRY 101 3/4" Ross | 83 E |
| (TOWNSHIP LINE) STGN QEES 41' ± | | x |
| 46.33 | | |
| 3. 3 * | TWIN 6" ASH Cherry | |
| S'BIK. OAK '94 O' | , je | |
| CONE 2 | j | |
| SECTION SAME | , | |

| ADAMS COUNTY | CORNER NO | 5/3 |
|-------------------------------------------------------------------------------------------------------------------------------------------------------------------------------------------------------|--------------------------------------------------------------------------------------------------------------------------------------------------------------------------------------------------------------------------------------------------------------------------------------------------------------------------------------------------------------------------------------------------------------------------------------------------------------------------------------------------------------------------------------------------------------------------------------------------------------------------------------------------------------------------------------------------------------------------------------------------------------------------------------------------------------------------------------------------------------------------------------------------------------------------------------------------------------------------------------------------------------------------------------------------------------------------------------------------------------------------------------------------------------------------------------------------------------------------------------------------------------------------------------------------------------------------------------------------------------------------------------------------------------------------------------------------------------------------------------------------------------------------------------------------------------------------------------------------------------------------------------------------------------------------------------------------------------------------------------------------------------------------------------------------------------------------------------------------------------------------------------------------------------------------------------------------------------------------------------------------------------------------------------------------------------------------------------------------------------------------------|---------------------------------------------------------------------------------|
| | SECTION | 1 |
| Survey Monument Record Harrison | TOWN | 15 |
| TYPE OF MONUMENT: | RANGE | 7 |
| STATE PLANE COORDINATES: N | V | |
| ELEVATION — M.S.L. DATUM: | ↑ · · | |
| THETA ANGLE: | h | 4 |
| FIELD BOOK: S-1063 PAGE | | |
| • | _ | IN |
| BASIS FOR MONUMENT LOCATION | | |
| (Use reverse side if necessary) | LOCATION | ` |
| Show info such as: History of corner, with reference to Vol. and pg, dates, surveyor; exact description of monument replaced; if location computed, by taped or EDM traverse; landowner remarks, etc. | (Indicated by 'X') | |
| CORNER SET AT INTERSECTIONS OF AN EAST-WEST FENCE LINE AND WHAT APPEARED TO BE THE REMIANS OF AN OLD NORTH-SOUTH FENCE LINE. | DALE D. PICE S-970 APPLETON, OR WIS. O SURVEY SURVEY AND SU | |
| DIGGING AT THIS LOCATION RECOVERED WHAT APPEARED TO BE AN OLD WOODEN FENCE POST. | RICE * | |
| THIS CORNER WAS INCLUDED IN AN EXTENSIVE E.D.M. TRAVERSE. | APPLETON, OWIS. | SP SP SP SP SP SP SP SP SP SP SP SP SP S |
| 2-19-86 11 4-1-9: | | |
| 1 NEW TIE 3-8-35 - JG 1-NEW TIE 3-8-35 - JG TICH ON 3-24-08 - MC | CERTIFIED CORRECT: Registered Land Surveyor DATE: 12/13/74 | |
| TIE SKETCH | | |
| | | |
| (Show at least four ties) BURR PK. IN 6" OAK | SEE SUE) OF O ZNO GUE SO O GORNOGO | 4 |
| | * | N |
| P.K. IN II"OAK (TOWNSHIP LINE) | 10 CHERRY JET | |
| × × × × × × | TWIN 6" ASH | X |
| | | |

TION