ADAMS COUNTY COUNTY COUNTY CORNER NO: 18

ROMPORTOL ID: 41507032000


PUBLIC LAND SURVEY MONUMENT RECORD

2" ANGLE IRON TYPE OF MONUMENT: ADAMS COUNTY COORDINATES, NAD 83 (2007) N. 161947.518 E. 578480.486 **ELEVATION-**DATUM 03/02/2021 FIELD WORK DATE:____


BASIS FOR MONUMENT LOCATION

1980 - PLS 1478 ACCEPTED FENCE CORNER POST AS BEST EVIDENCE FOR LOCATION OF THIS CORNER. THIS POINT FALLS 2.11 FEET NORTH AND 10.55 FEET EAST OF THE PROPORTIONATE LOCATION. DUE TO THE CLOSENESS OF MEASURED DISTANCES TO ADJACENT CORNERS TO THE RECORDED ORIGINAL DISTANCES AND THE OBVIOUS CONTINUAL MAINTENANCE OF FENCES IN THE AREA THIS POINT WAS ACCEPTED OVER THE PROPORTIONATE LOCATION AS THE CORNER. NO RECORD OF MONUMENTATION SUBSEQUENT TO THE ORIGINAL WAS FOUND AND NO EVIDENCE OF ANY OTHER MONUMENTATION WAS FOUND.

2021 - PLS 2675 FOUND 2" ANGLE IRON FENCE CORNER AND 2 WITNESS TREES. THE MONUMENT AGREES WITH BOTH WITNESS TREES. ACCEPTED THE 2" ANGLE IRON AS THE CORNER LOCATION. SET 4 NEW TIES AND MEASURED TO THE EXISTING WITNESS TREES.

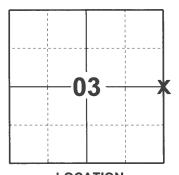

LOCATION (INDICATE CORNER BY "X")

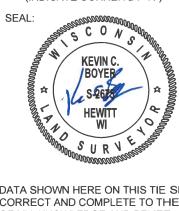

DATA SHOWN HERE ON THIS TIE SHEET IS CORRECT AND COMPLETE TO THE BEST OF MY KNOWLEDGE AND BELIEF.


PROFESSIONAL LAND SURVEYOR DATE

- TIE SKETCH



FIELD

- SET 3/4" x 18" IRON REBAR, 1.50#/FT
- FOUND 2" ANGLE IRON
- VINYL "T" POST
- WITNESS TREE

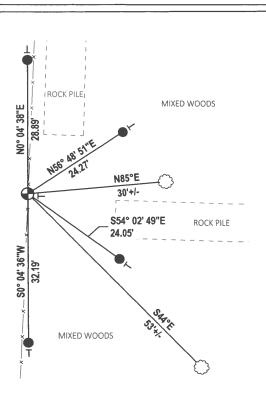

Government Land Corner Certifi	cate	
ADAMS Count		corner no. $\frac{8}{8}$
ADAMS Count TYPE OF MONUMENT: Existing steel Ang	y le. set in concrete	SECTION
STATE PLANE COORDINATES: N		TOWN
E	• • • • • • • • • • • • • • • • • • •	range 7
ELEVATION M.S.L. DATUM:		
THETA ANGLE:		
FIELD BOOK: A-F 2 PAGE 79	9	Section
DRAWN BY: Gregory P. Rhinehart		2-15-7
		או
BASIS FOR MONUMENT LOCATION		
Show info such as: History of corner, with reference to Vand pg., dates, surveyor; exact description of monuments	ol. ent	
and pg., dates, surveyor; exact description of monume replaced; if location computed, by taped or EDM traver andowner remarks, etc. (Use reverse side if necessary)	rse;	LOCATION (Indicated by 'X')
, , , , , , , , , , , , , , , , , , , ,	SEAL:	(indicated by 11)
Accepted Fence corner post as best e	vidence for	-44111111111111111111111111111111111111
location of this corner. This point	falls 2.11 feet	MINSCONC
north and 10.55 feet east of the property	portionate location.	
Due to the closeness of measured discorners to the recorded original discorners		GREGORY P.
obvious continual maintenance of fend	ces in the area	RHINEHART S-1478
this point was accepted over the propas the corner.	portionate location	FRIENDSHIP.
as one corner.		Wis.
No record of monumentation subsequent	t ot the original	WIS. SURVEINING
was found and no evidence of any other		
was loung.		SHOWN HERE ON TIED CORRECT:
	\mathcal{L}	reapy of Rhinehart
	Registere	ed Land Surveyor
	DATE:	10-4-80
гіе ѕкетсн	m NW Car	
	2 -15-7	10" 0-0-1
Show at least four ties, also fence lines, roads, topo, size and type of witness trees' and if off road - best way to		10" Aspen/BT
rrive at corner.	The Walter of th	
Note: Ties are to noil & disc.	70n 7809.1 72 E 23 E	
in blazed trees.	yer yer	
	25.80 x x 2800 x x 2800 x x x 2800 x x x 2800 x x x x x x x x x x x x x x x x x x	B 6"CHERRY OI
	777	By 6"CHERRY'SI
	R	emnants of fence
	a is the	X X X
	A Sa	<i>761</i>
	2640 2640 266	
	N S S N	Fine Pine
	SZ Z Z Z Z Z Z Z Z Z Z Z Z Z Z Z Z Z Z	T Pine
	Main Main 18 18 18 18 18 18 18 18 18 18 18 18 18	9' U.OAK/SIGN 'OI
		U.OAR/S/ER C/
	SW SW	2

MAINTENANCE RECORD

BY WHOM	REMARKS
LC-NJ	TIES + MON. O.K
GK-55	•
GR- JG	et of U
55	Z 14000 7105
m5	OF
	LC-NT GK-SS GR-TG