


ADAMS COUNTY

CORNER NO. 503
 SECTION 7
 TOWN 15
 RANGE 7

Survey Monument Record

TYPE OF MONUMENT: CAST IRON HARRISON
 STATE PLANE COORDINATES: N _____
 E _____
 ELEVATION — M.S.L. DATUM: _____
 THETA ANGLE: _____
 FIELD BOOK: _____ PAGE _____

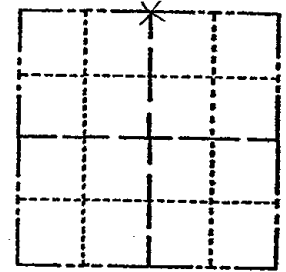


LOCATION
(Indicated by 'X')

BASIS FOR MONUMENT LOCATION

(Use reverse side if necessary)
 Show info such as: History of corner, with reference to Vol. and pg, dates, surveyor; exact description of monument replaced; if location computed, by taped or EDM traverse; landowner remarks, etc.
9/5/74

FOUND EXISTING PK. NAIL CENTERLINE OF FERN AVENUE, FIT EDM TRAVERSE GOOD.

CORNER O.K. 10-28-76 RN-SS

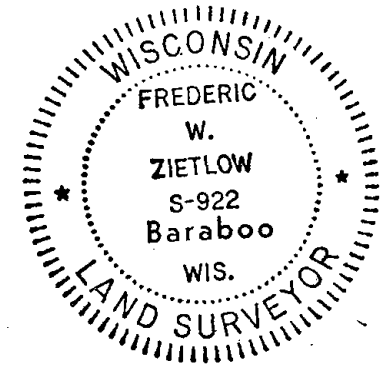

MAINTENANCE RECORD

Date	Init.	Remarks
12-21-81	TH-NJ	Corners O.K.
2-3-86	GR-SS	" "
3-26-91	JG	1-GONE CORNER OK
11-21-95	SS	OK
2-16-01	JG	3-NEW, MON. OK
6-8-06	JG	OK
2-15-11	SS	"

CERTIFIED CORRECT:
Frederic W. Zietlow
 Registered Land Surveyor
 DATE: 9 SEPT. 1974

TIE SKETCH

(Show at least four ties)

