

06
SECTION

15
TOWN

07
RANGE

ADAMS COUNTY

COUNTY CORNER NO: 23

ROMPORTOL ID: 41507060000

PUBLIC LAND SURVEY MONUMENT RECORD

TYPE OF MONUMENT: HARRISON
ADAMS COUNTY COORDINATES, NAD 83 (2007)

N. 159336.198

E. 562641.756


ELEVATION- _____ DATUM _____

FIELD WORK DATE: 03/03/2021

BASIS FOR MONUMENT LOCATION


1974 - PLS 922 FOUND EXISTING NAIL CENTERLINE OF FERN AVENUE OFF FENCE TO SOUTH. FIT EDM TRAVERSE GOOD.

2021 - PLS 2675 FOUND A HARRISON MONUMENT 4"± BELOW THE ROAD SURFACE AND 2 TIES. THE MONUMENT AGREES WITH BOTH TIES. ACCEPTED THE HARRISON AS THE CORNER LOCATION. SET 2 NEW TIES, MEASURED TO A FOUND PROPERTY IRON, AND THE EXISTING TIES.

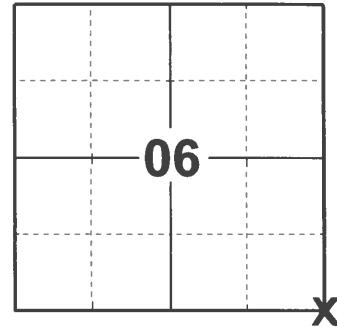

LOCATION
(INDICATE CORNER BY "X")

SEAL:

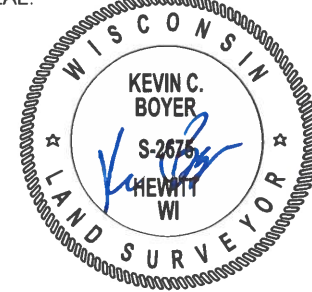



DATA SHOWN HERE ON THIS TIE SHEET IS CORRECT AND COMPLETE TO THE BEST OF MY KNOWLEDGE AND BELIEF.

PROFESSIONAL LAND SURVEYOR

DATE 5/20/21

- TIE SKETCH

NOTE: THE CORNER LANDS ON THE CENTERLINE OF FERN AVE.

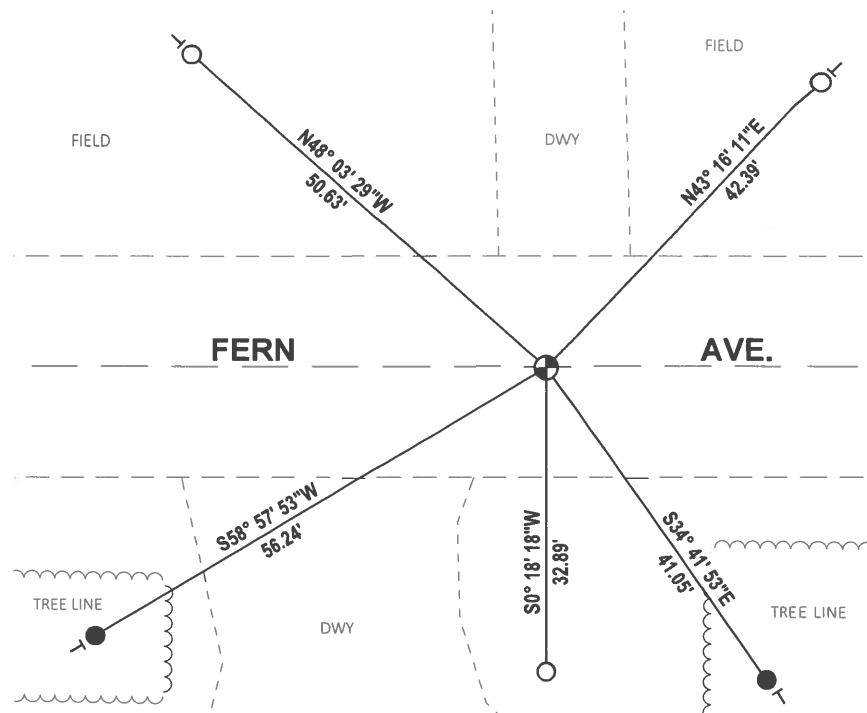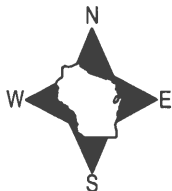


- SET 3/4" x 18" IRON REBAR, 1.50#/FT
- FOUND 3/4" IRON ROD
- ⊙ FOUND HARRISON MONUMENT
- └ VINYL "T" POST

ADAMS COUNTY

Survey Monument Record

TYPE OF MONUMENT: CAST IRON HARRISON
 STATE PLANE COORDINATES: N _____
 E _____
 ELEVATION — M.S.L. DATUM: _____
 THETA ANGLE: _____
 FIELD BOOK: _____ PAGE _____

CORNER NO. 504
 SECTION 7
 TOWN 15
 RANGE 7

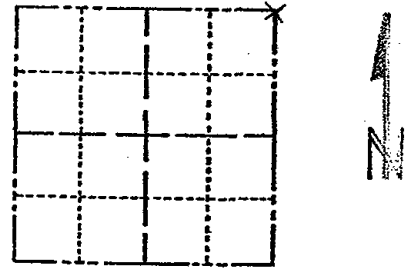


LOCATION
(Indicated by 'X')

BASIS FOR MONUMENT LOCATION

(Use reverse side if necessary)
 Show info such as: History of corner, with reference to Vol. and pg, dates, surveyor; exact description of monument replaced; if location computed, by taped or EDM traverse; landowner remarks, etc.
 9/5/74

SEAL:

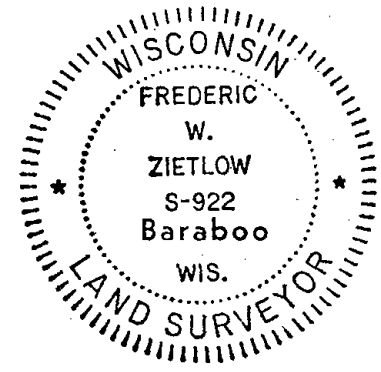

FOUND EXISTING NAIL CENTERLINE OF FERN AVENUE OFF FENCE TO SOUTH FIT EDM TRAVERSE GOOD.

corners o.k 1-28-76 RN-SS

MAINTENANCE RECORD

Date	Init.	Remarks
12-21-81	TH-NJ	Ties o.k.
2-3-86	GR-SS	" "
3-26-91	JG	All OK
11-21-95	SS	OK
2-16-01	JG	OK
6-8-06	JG	OK
2-15-11	SS	2 NEW TIES

CERTIFIED CORRECT:

Frederic W. Zietlow

Registered Land Surveyor

DATE: 9, SEPT. 1974

TIE SKETCH

(Show at least four ties)

