OT RANGE ADAMS COUNTY CORNER NO: 30 ROMPORTOL ID: 41507020020

PUBLIC LAND SURVEY MONUMENT RECORD


HARRISON TYPE OF MONUMENT: ADAMS COUNTY COORDINATES, NAD 83 (2007) N. 159286.609 E. 581060.985 - --- DATUM_ **ELEVATION-**FIELD WORK DATE: 03/01/2021

BASIS FOR MONUMENT LOCATION

1976 - PLS 922 FOUND 4"X4"X10" STONE NOT ON RECORD. BELIEVED THIS STONE WAS SET BY M.C.SMITH OR H.C. AMUNDSON AS IN REVIEWING OLD SURVEY NOTES. THEY BOTH VISITED THIS CORNER ON DIFFERENT OCCASIONS. FITS THEIR DISTANCES ALONG NORTH-SOUTH 1/4 LINE WHEN DISTANCES ARE PRORATED.

2006 - PLS 2357 LOCATED AND TIED TO THIS CORNER WHICH WAS THEN TAKEN OUT DUE TO ROAD CONSTRUCTION. THEN REPLACED CORNER WITH A HARRISON MONUMENT AFTER COMPLETION OF ROAD AND SET NEW TIES AS SHOWN.

2021 - PLS 2675 FOUND A HARRISON MONUMENT 3" BELOW THE ROAD SURFACE, 1 TIE, AND 1 WITNESS. THE MONUMENT AGREES WITH BOTH THE TIE AND WITNESS. ACCEPTED THE HARRISON AS THE CORNER LOCATION. SET 3 NEW TIES AND MEASURED TO THE EXISTING TIE AND WITNESS.

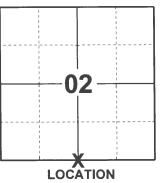

(INDICATE CORNER BY "X")



DATA SHOWN HERE ON THIS TIE SHEET IS CORRECT AND COMPLETE TO THE BEST OF MY KNOWLEDGE AND BELIEF.

PROFESSIONAL LAND SURVEYOR DATE 5/20/21

- TIE SKETCH

NOTE: WITNESS IS OUTSIDE CORNER END OF CURB AND GUTTER.



S89°W MIXED WOODS 21'+/-MIXED WOODS

- SET 3/4" x 18" IRON REBAR, 1.50#/FT
- O FOUND 3/4" IRON ROD
- FOUND HARRISON MONUMENT
- → VINYL "T" POST

ADAMS COUNTY GOVERMENT LAND CORNER CERTIFICATE

TYPE OF MONUMENT: STANDARD HARRISON A.C.C.S COORDINATES N: 159286.52 E:581061 30


ELEV. M.S.L. DATUM:

THETA ANGLE:

FIELD BOOK:

PAGE:

DRAWN BY: KELLY D. CALLAWAY

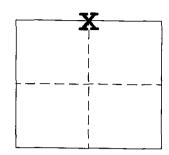

CORNER NO. (30)


SECTION 11 TOWN 15 NORTH RANGE 7 EAST



BASIS FOR CORNER LOCATION

FRED ZIETLOW: Found a 4"x4"x10" Stone and replaced it with a harrison in March of 1976

July of 2006 I located and tied to this corner which was then taken out due to road construction. I then replaced corner with a Harrison monument after completion of road and set new ties as shown.

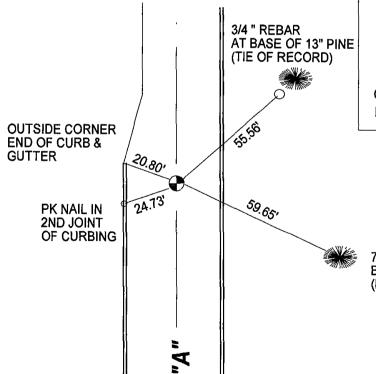

SEAL

CERTIFIED CORRECT
REGISTERED LAND SURVEYOR

7" PINE BT/SIGN (NAIL)

CENTRAL STAKING INC

Stevens Point, WI 54481 Office: 715-345-6904 Fax: 715-345-7728

ADAMS COUNTY	CORNER NO. 922
Survey Monument Record	SECTION 11
TYPE OF MONUMENT: 30" HARRISON	TOWN
STATE PLANE COORDINATES: N	RANGE 7E
ELEVATION — M.S.L. DATUM:	
FIELD BOOK: PAGE	1 7.
BASIS FOR MONUMENT LOCATION	
(Use reverse side if necessary)	LOCATION
Show info such as: History of corner, with reference to Vol. and pg, dates, surveyor; exact description of monument replaced; if location computed, by taped or EDM traverse; landowner remarks, etc.	SEAL: (Indicated by X') SEAL: (Indicated by X') SEAL: (Indicated by X') SEAL: (Indicated by X') FREDERIC W. ZIETLOW S-922 Baraboo WIS. ONE WIS. WIS. ONE WIS. ONE WIS. WIS. WIS. WIS. WIS. WIS. WIS.
FOUND 4"X4"X10" STONE NOT ON RECORD.	21/1/11/11/1/1/1/1/1/1/1/1/1/1/1/1/1/1/
I BELIEVE THIS STONE WAS SET BY	THIN SOONS WILL
M.C. SMITH OR H.C. AMUNDSON AS IN	S ART FREDERIC W.
REVIEWING OLD SURVEY NOTES THEY BOTH	ZIETLOW
VISITED THIS CORNER ON DIFFERENT	E* s-922
OCCASSIONS. FITS THEIR DISTANCES	Baraboo
ALONG N-5 MY LINE WHEN DISTANCES	WIS.
ARE PROPATED . MAINTENANCE RECORD	SURVINI
Date Init. Remarks	· · · · · · · · · · · · · · · · · · ·
9-15-81 NJ-LC MON. & TIES O.K	CERTIFIED CORRECT:
6-15-85 GK KEN CARLSON	Fredery W. Vietow
2-19-86 OF GR-SS	Registered Land Surveyor
4-1-91 OK GR-JG 4-19-96 DK JG-55	DATE: MARCH 16.1976
	1. Comment of the state of the
(Show at least four ties)	JG /ALSO SEE TIE SHEET BY CENTEAL STAKING ME (JULY OF ZWG ON BACKSIDE)
, R	_
*	4
H 7.	MI NI
NAIL & SHINER W	AT BASE OF B"RED PINEBL
IN 7"BLACK X	15/2 SI EN
SIGN 344 IRON X BAR	"
BAR 33.00	
x x x	6-
	30°
وي ا	NAIL & SHINER
	DND SIGN
	A IN UTILITY POLE