OT ADAMS COUNTY COUNTY CORNER NO: 43

ROMPORTOL ID: 41507070000

PUBLIC LAND SURVEY MONUMENT RECORD

HARRISON TYPE OF MONUMENT: ADAMS COUNTY COORDINATES, NAD 83 (2007)

N. 154065.756

E. 562623.105


- — — DATUM_ ELEVATION-

FIELD WORK DATE:___ 03/09/2021

BASIS FOR MONUMENT LOCATION

1974 - PLS 878 EXCAVATED CORNER LOCATION WITH BACKHOE.FOUND RAILROAD SPIKE ALSO USED IN SURVEYS NORTH AND WEST OF CORNER LOCATION. RAILROAD SPIKE FIT POSSESSION LINES WELL. NO RESURVEYS OF RECORD CONCERNING THIS POINT. PLS 878 REPLACED RAILROAD SPIKE WITH HARRISON MONUMENT.

2021 - PLS 2675 FOUND HARRISON MONUMENT 2" BELOW ROAD SURFACE. HARRISON MONUMENT AGREES WITH FOUND TIE AND WITNESS. ACCEPTED THE HARRISON MONUMENT AS THE CORNER LOCATION. SET 3 NEW TIES AND MEASURED TO THE EXISTING TIE AND WITNESS.

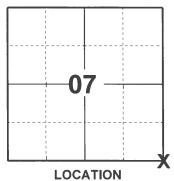

(INDICATE CORNER BY "X")



DATA SHOWN HERE ON THIS TIE SHEET IS CORRECT AND COMPLETE TO THE BEST OF MY KNOWLEDGE AND BELIEF.


PROFESSIONAL LAND SURVEYOR

- TIE SKETCH

NOTE: CORNER LANDS ON THE CENTERLINE OF FISH AVE.



- SET 3/4" x 18" IRON REBAR, 1.50#/FT
- FOUND 1-1/4" O.D. IRON PIPE
- FOUND HARRISON MONUMENT
- STEEL FENCE POST
- VINYL "T" POST

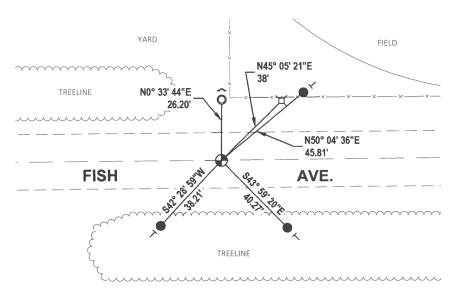

ADAMS COUNTY		•		CORNER NO	650
Survey Monument Record				SECTION	
TYPE OF MONUMENT: HARRISON				TOWN _	15
STATE PLANE COORDINATES: N				RANGE .	
ELEVATION — M.S.L. DATUM: THETA ANGLE: FIELD BOOK: PAGE BASIS FOR MONUMENT LOCATION (Use reverse side if necessary) Show info such as: History of corner, with referentiand pg, dates, surveyor; exact description of monumentif location computed, by taped or EDM traverse; remarks, etc. Excavated with backhoe. Found rail and nothing else. Spike fit possesiand was apparently used in surveys west of here. Replaced spike with Here	ce to Vol. t replaced; landowner road spike on lines north and	· · · · · · · · · · · · · · · · · · ·	SEAL:	LOCATION Indicated by 'X') SCONS ANTHONY B	A N
No resurveys of record for this poin	·	runcii v		KIEDROWSKI S-878 Wisconsin Rapids, Wis.	¢.
MAINTENANCE RECORD Date Init. Remarks = 12-30-81 TH-NJ Mon. O. K	RN-SS	·	No.	SURVENIEN	
7-3-86 GR OR 3-26-91 SG ALL OK 1121-95 SS 3 NEW TIES 2-16-01 JG OK 6-8-06 SC OK 2-18-11 SS "		~	Anor.	CORRECT: md Surveyor t., '74	elw-z
TIE SKETCH		,			-
(Show at least four ties)	Existing /"IO.TP	* * * * * * * * * * * * * * * * * * *	36.4 21.25 36.4	A" BURR OAH / BJCT, BOX PO	WER LE
	16"	BURR			