# OT ADAMS COUNTY COUNTY CORNER NO: 51

ROMPORTOL ID: 41507110000

### PUBLIC LAND SURVEY MONUMENT RECORD

**HARRISON** TYPE OF MONUMENT: ADAMS COUNTY COORDINATES, NAD 83 (2007) N. 154064.733 E. 583660.126

- --- DATUM\_ ELEVATION-


#### BASIS FOR MONUMENT LOCATION

FIELD WORK DATE:


1974 - PLS 417 RAN TRAVERSE CONNECTING ALL EXISTING MONUMENTS OF EVIDENCE IN ALL OF SECTIONS 12 AND 13. LOCATION DETERMINED BY COMPUTED COORDINATES.

03/04/2021

2021 - PLS 2675 FOUND HARRISON MONUMENT 6" BELOW ROAD SURFACE, 2 TIES AND 1 WITNESS. MONUMENT AGREES WITH ALL TIES AND WITNESS, ACCEPTED HARRISON MONUMENT AS THE CORNER LOCATION. SET 3 NEW TIES AND MEASURED TO A FOUND PROPERTY CORNER AND THE EXISTING TIES AND WITNESS.

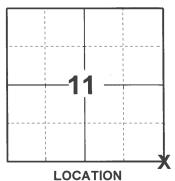

(INDICATE CORNER BY "X")

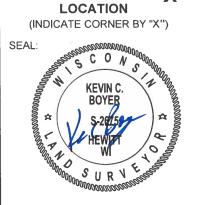

DATA SHOWN HERE ON THIS TIE SHEET IS CORRECT AND COMPLETE TO THE BEST OF MY KNOWLEDGE AND BELIEF.


PROFESSIONAL LAND SURVEYOR DATE\_

#### -TIE SKETCH

NOTE: CORNER LANDS 6.3'± EAST OF THE CENTERLINE OF 2ND AVE.



- SET 3/4" x 18" IRON REBAR, 1.50#/FT
- FOUND 3/4" IRON ROD
- FOUND HARRISON MONUMENT
- STEEL FENCE POST
- VINYL "T" POST

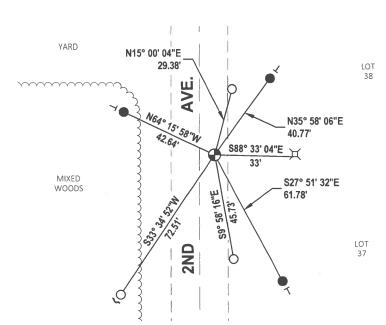

ADAMS COUNTY		CORNER NO	
Survey Monument Record		SECTION	
TYPE OF MONUMENT: HARRISON		TOWN	15 N
STATE PLANE COORDINATES: N		RANGE	7 <i>Ē</i>
		<del>\                                    </del>	
ELEVATION — M.S.L. DATUM:	· · · · · · · · · · · · · · · · · · ·		
FIELD BOOK: Clip sheets PAGE			
• • • • • • • • • • • • • • • • • • • •			N
BASIS FOR MONUMENT LOCATION		=	
(Use reverse side if necessary)			
Show info such as History of corner with reference	e to Vol.	LOCATION	
and pg, dates, surveyor; exact description of monument if location computed, by taped or EDM traverse; l remarks, etc.	t replaced; landowner	SEAL: (Indicated by 'X')	)
Location determined by concoordinates from an extens traverse connecting all exmonuments and evidence in sections 12-13. No fence I the vicinity. No digging obecause of large amount of road.  Corner O K 10-28-76  ALL OK 4-1-91 GR-36	sive  kisting  all of  lines in  lone  f fill in	R. K. SAYLER Winnecons S-4/2 SURV	ne 🔻
		P. Ki hayle	<u> </u>
		Registered Dand Surveyor DATE: 74	
		DATE:	
TIE SKETCH			•
(Show at least four ties)	ZMB AVE.	3/4" Rop 5'044 Deace 1	is der
" — "	35.20' 7"	17.95' 2" IRON PIP 34.85' \$\frac{1}{3}\$ \$\text{SW COR } & \text{COR } & \text{SW COR } & \t	93" E Painted Orange Le Box
"T" I RON PAINTED ORANGE		MAINTENANCE	RECORD
25	2/	Date Init.	Remarks
	4%	12-30-81 TH NJ MOU 2-3-86 GR-55 "	0.K.
New 10"BIK Date	a 1	12-9-93 (SEE ATTACK	LED SHEET)
10"BIK Wat 187		Mark Andreas Contraction from the Annual Andreas Contraction and Annual Contraction of the Contraction of th	1-NEW
	3/4" ROLL TOP	2-28-01 JG-55 OK	
		3-8-06 JG OK	

## ADAMS COUNTY CORNER NO. Survey Monument Record SECTION TYPETOF MONUMENT CHARRISON TOWN STATE PLANE COORDINATES IN RANGE ELEVATION — M.S.L.; DATUM; THETA ANGLE; FILLD BOOK! Clip sheets PAGE BASIS FOR MONUMENT LOCATION CUse reverse side if necessary) ... Show info such as: History of corner, with reference to Vol. and pg. dates, survey exact description of monument replaced; if flocation computed, by staped or; EDM traverse; landowner remarks, etc. LOCATION (Indicated by X') SEAI Location determined by computed coordinates from an extensive traverse connecting all existing monuments and evidence in all of sections 12-13. No lence lines in the vicinity. No digging done because of large amount of fill in road. CERTIFIED CORRECT Registèred : Lind Surveyo TIE SKETCH (Show at least four ties) T I RON PAINTED COM MAINTENANCERECORD Africa Remarks Option