# OT ADAMS COUNTY COUNTY

ROMPORTOL ID: 41507182000

## PUBLIC LAND SURVEY MONUMENT RECORD

**HARRISON** TYPE OF MONUMENT:\_ ADAMS COUNTY COORDINATES, NAD 83 (2007)

N. 151422.852

E. 562616.062


ELEVATION- - - DATUM

FIELD WORK DATE: 04/01/2021

#### BASIS FOR MONUMENT LOCATION

1976 - PLS 1103 RAN EDM/T2 TRAVERSE AROUND SECTIONS 18 AND 19 TO DETERMINE SEARCH AREAS. FOUND STANDING BEARING TREE AS PER RAYMOND PHILLIPS NOTES ON MAY 8, 1939 (VOLUME 2, PAGE 135 OF ADAMS COUNTY SURVEY RECORD) AND REMAINS OF POST AT PRESCRIBED DISTANCE AND DIRECTION. REMONUMENTED POST WITH HARRISON MONUMENT.

2021 - PLS 2675 FOUND HARRISON MONUMENT 4' UNDER A DIRT PILE. DID NOT RECOVER ANY EXISTING TIES OR WITNESSES. ACCEPTED HARRISON MONUMENT AS THE CORNER LOCATION AND SET 4 NEW TIES.

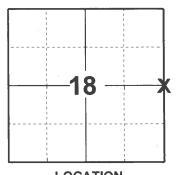

LOCATION

(INDICATE CORNER BY "X")




DATA SHOWN HERE ON THIS TIE SHEET IS CORRECT AND COMPLETE TO THE BEST OF MY KNOWLEDGE AND BELIEF.

PROFESSIONAL LAND SURVEYOR

#### -TIE SKETCH

NOTE: MONUMENT IS 4' BENEATH DIRT PILE.



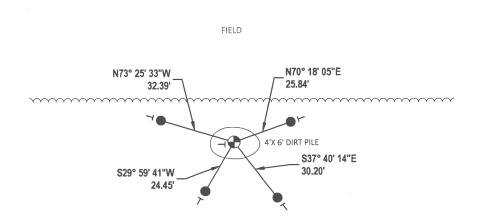

- SET 3/4" x 18" IRON REBAR, 1.50#/FT
- FOUND HARRISON MONUMENT
- VINYL "T" POST

MIXED WOODS

### ADAMS COUNTY SECTION Survey Monument Record TYPE OF MONUMENT: Harrison TOWN RANGE STATE PLANE COORDINATES: N. E ELEVATION — M.S.L. DATUM: \_\_\_ THETA ANGLE: \_\_\_\_\_ FIELD BOOK: \_\_\_\_\_\_ PAGE \_\_\_\_\_ BASIS FOR MONUMENT LOCATION (Use reverse side if necessary) DALE C. HAGEN S-1103 Wisconsin Rapids, Wis. LOCATION Show info such as: History of corner, with reference to Vol. and pg, dates, surveyor; exact description of monument replaced; if location computed, by taped or EDM traverse; landowner SEAL: remarks, etc. Ran EDM/T-2 traverse around Sections 18 and 19 to determine search areas for investigation. Found standing bearing tree as per notes of Raymond Phillips on May 8, 1939 (Vol 2 Page 135 of Adams County Survey Records) at(S 87° W 10" Black Oak 63 3/4 links) and remains of post at prescribed distance and direction. Remonumented Post with Harrison Monument. on May 27, 1976. CERTIFIED CORRECT: Registered Land Surveyor DATE: July TIE SKETCH (Show at least four ties) NOTE FIELD Ties in trees to nail in disc. ACCESSABL AREA COVERED / ROCK DIRT ETC! FIELD

REVISED 1974

DND

SIGN

NO X 6" WHITE

12-30-81 771-NJ MON & LIES OF 2-3-86 GC 55 OK 5-8-91 JG-G5 TIES OK 11-21-95 SS " " " 2-21-01 SG-MH ALL DK COENER

ALL OK CONNER SCENS TO FALL

-NOT (WORR PILE OF FILED STONE)