

## PUBLIC LAND SURVEY MONUMENT RECORD

TYPE OF MONUMENT: 1.0" IRON ROD  
 ADAMS COUNTY COORDINATES, NAD 83 (2007)

N. 151397.566

E. 588974.102


ELEVATION-      DATUM     

FIELD WORK DATE: 2/1/2017

### BASIS FOR MONUMENT LOCATION

1974- PLS 417 SET HARRISON ON A STRAIGHT LINE EQUIDISTANCE BETWEEN SECTION CORNERS ON THE BASIS OF COMPUTED COORDINATES. CORNER FALLS ON A NORTH-SOUTH FENCE LINE WITHIN THE RIGHT-OF-WAY OF STH 82.

2017 - PLS 2994 FOUND EXISTING 1.0" IRON ROD 6" BELOW SURFACE. ACCEPTED THE 1.0" IRON ROD AND SET 3 NEW TIES AND MEASURE TO AN EXISTING PROPERTY IRON.

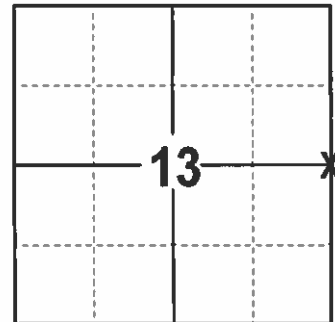

**LOCATION**  
 (INDICATE CORNER BY "X")

SEAL:





DATA SHOWN HERE ON THIS TIE SHEET IS CORRECT AND COMPLETE TO THE BEST OF MY KNOWLEDGE AND BELIEF.

PROFESSIONAL LAND SURVEYOR

DATE \_\_\_\_\_

### TIE SKETCH

NOTE: THE CORNER FALLS 28± NORTH OF THE CENTERLINE OF STH 82.

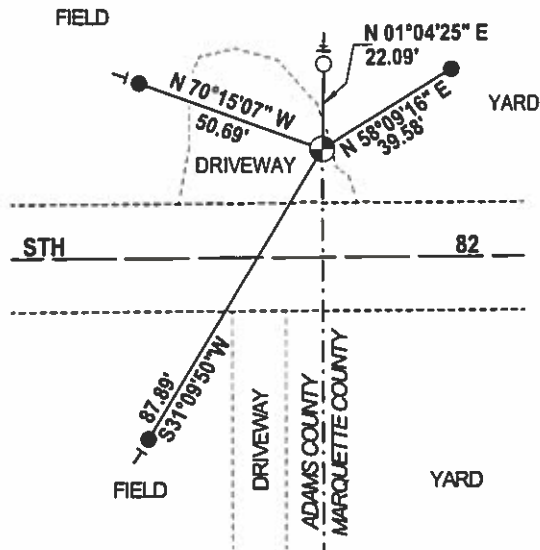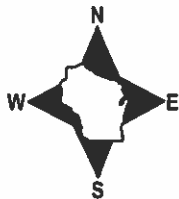


- 3/4" x 18" IRON REBAR SET, 1.50#/FT
- 3/4" IRON ROD FOUND
- ⊕ 1.0" IRON ROD FOUND
- ┆ VINYL "T" POST
- ┆ STEEL "T" POST

**ADAMS COUNTY**

**Survey Monument Record**

TYPE OF MONUMENT: HARRISON  
 STATE PLANE COORDINATES: N \_\_\_\_\_  
 E \_\_\_\_\_  
 ELEVATION — M.S.L. DATUM: \_\_\_\_\_  
 THETA ANGLE: \_\_\_\_\_  
 FIELD BOOK: Clip sheets PAGE \_\_\_\_\_

CORNER NO. 355  
 SECTION 13  
 TOWN 15 N  
 RANGE 7E

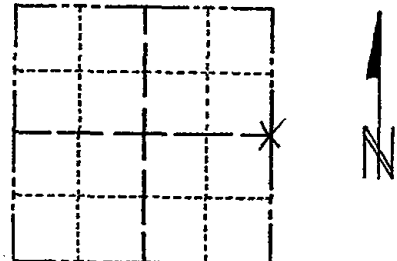

LOCATION  
(Indicated by 'X')

**BASIS FOR MONUMENT LOCATION**

(Use reverse side if necessary)

Show info such as: History of corner, with reference to Vol. and pg, dates, surveyor; exact description of monument replaced; if location computed, by taped or EDM traverse; landowner remarks, etc.

SEAL:



Set on a straight line equidistant between section corners on the basis of computed coordinates.

On line with N-S fence line.

Corner located within R.O.W. of St. Trk. Hwy. "82"

Harrison, broken-replaced 10-29-76 RM-SS  
 OR GR-SS 2-19-86  
 P.A. REMAIN 5-8-91 JG-SS  
 " " 4/3/96 JG-SS


CERTIFIED CORRECT:

R. K. Saylor  
 Registered Land Surveyor  
 DATE: 1/15/74

(FD 1" ROD AT CORNER LOCATION) 1-TIE LEFT TO MEASURE CHECK MARQUETTE TO SURVEYOR FILES  
 3-8-06 JG  
 3-17-11 JG

**TIE SKETCH**

(Show at least four ties)

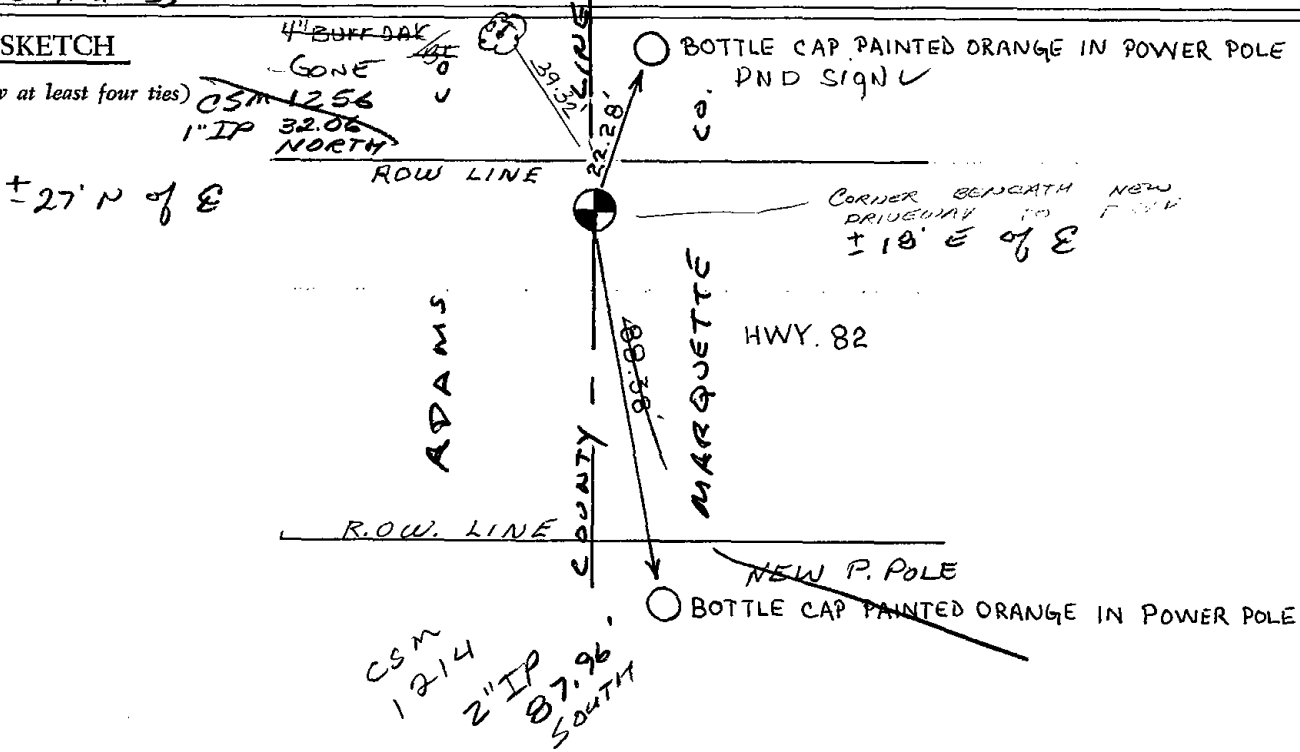

MAINTENANCE RECORD

Date	Part	Remarks
12-30-81	TH-NJ	MOTOR TIES O.K