U.S. PUBLIC LAND SURVEY MONUMENT RECORD

ADAMS COUNTY

This record shall show the location of the corner and shall include all of the following nine elements (a through i)

TYPE OF MONUMENT: BERNTSEN SURVEY MARKER NAIL

ADAMS COUNTY COORDINATES: N: 148776.455

E: 562609.590

ELEVATION: -M.S.I., DATUM ELLIP, HEIGHT:

LATITUDE:

LONGITUDE:

(b) Describe any record evidence, monument evidence, occupational evidence, testimonial evidence, or any other material evidence considered by the professional land surveyor, and whether the monument was found or placed

ANTHONY J. ALT, PLS 2038 FOUND A HARRISON MONUMENT AND TIED PRIOR TO RECONSTRUCTION OF HWY "82". HE FOUND EXISTING REFERENCE TIES, DISC SET IN CONCRETE STATING "WISCONSIN DEPT. OF TRANSPORTATION, DO NOT DISTURB". PER PREVIOUS TIE SHEET DATED JULY 6, 2015.

KEVIN C. BOYER, PLS 2675 FOUND NO MONUMENT DUE TO HIGHWAY CONSTRUCTION BUT FOUND 4 TIES. HE CALCULATED POSITION BY DISTANCE - DISTANCE INTERSECTION FROM THE NORTHWEST, NORTHEAST, SOUTHEAST AND SOUTHWEST TIES AND AVERAGED THE SOLUTIONS. HE ACCEPTED THE CALCULATED POSITION AS THE CORNER LOCATION. NO MONUMENT WAS SET AT THE TIME OF SURVEY. PER PREVIOUS TIE SHEET DATED MAY 19, 2021.

ON JULY 22, 2020, I FOUND A BERNTSEN SURVEY MARKER NAIL AT THE CORNER LOCATION AND FOUR EXISTING WITNESS MONUMENTS AS SHOWN ON PREVIOUS TIE SHEET DATED JULY 6, 2015. EXISTING MONUMENT CHECKED WELL WITH WITNESS MONUMENTS AND WAS ACCEPTED AS THE CORNER LOCATION. MONUMENT AND WITNESSES WERE TIED BEFORE RECONSTRUCTION OF STATE HWY "82". ON MAY 20, 2021, AFTER CONSTRUCTION WAS COMPLETE, I SET A BERNTSEN SURVEY NAIL IN CONCRETE AT THE PREVIOUS SURVEYED LOCATION AND VERIFIED ALL WITNESS MONUMENTS AS PREVIOUSLY FOUND, WHICH WERE IN GOOD CONDITION.


- (c) In the plan view drawing below, provide reference ties to at least 4 witness monuments. Witness monuments shall be concrete, natural stone, iron, bearing trees or other equally durable material, except wood other than bearing trees.
- (d) Show a plan view drawing depicting the relevant monuments and reference ties which is sufficient in detail to enable accurate relocation of the corner monument if the corner monument is disturbed.

DRAFTED BY JORDAN G. BROST DRAWN BY TRAVIS PLANTICO

TIE SKETCH:

(SCALE: 1"=40')

-- ou ---

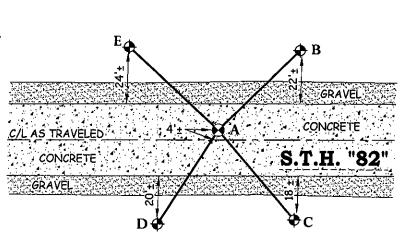

☐ FOUND IX SET

П X RE-TIED

RE-SET

FIRST

SECOND THIRD

FOURTH UNKNOWN

OTHER

ORDER OF ACCURACY:

REFERENCE DATUM: NAD 83 (2011)


Land Surveying Landscape Architecture Engineering Jordan G. Brost, PLS #3009 4941 Kirschling Court Stevens Point, W(5448) 715.344.9999(Ph) 715.34

(a) Identify the corner by reference to the U.S. public land survey system.

corner no. 63 ROMPORTOL ID: 41507180000

SECTION 18 **15** NORTH TOWNSHIP_

07 RANGE **EAST**

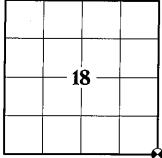

SECTION IDENTIFICATION

LEGEND AND NOTES:

- SET BERNTSEN SURVEY MARKER NAIL
- DOT ALUMINUM CAP MONUMENT IN CONCRETE FOUND
- \emptyset POWER POLE

45°25'40" E) A-B N 45°24'39"É

40'16'10" E) **40°25'14"E** A-C

32°24′37″W A-D

N 46°59'40"W 50.94 A-E

COORDINATES ARE REFERENCED TO THE ADAMS COUNTY COORDINATE SYSTEM AS DEVELOPED BY THE WISCONSIN DEPARTMENT OF TRANSPORTATION.

SHEET 1 OF 2

U.S. PUBLIC LAND SURVEY MONUMENT RECORD ADAMS COUNTY



Landscape Architecture Jordan G. Brost, PLS #3009

(e) A description of any material discrepancy between the location of the corner monument as restored and the monument location of that corner as previously established.

4941 Kirschling Court Stevens Point, WI 5448 715.344.9999(Ph) 715.3 (a) Identify the corner by reference to

the U.S. public land survey system. corner no. <u>63</u> ROMPORTOL ID: 41507180000 18 SECTION 15 NORTH TOWNSHIP.

07 RANGE **EAST**

(f) Was the corner restored through acceptance of (1) an obliterated evidence location, or (2) a found perpetuated location.

FOUND PERPETUATED LOCATION

(g & h) Was the corner reestablished through lost corner proportionate methods? If so, show the method, including the directions and distances to other public land survey corners used as evidence or used for proportioning in determining the corner location.

18 ·


SECTION IDENTIFICATION

(i) I, Jordan G. Brost, hereby certify that the corner location shown on this record was determined by me or under my direction and control and that this U.S. Public Land Survey Monument Record is correct and complete to the best of my knowledge and belief.

Jordan G. Brost, PLS # 3009

Oct. 11, 2021

Date

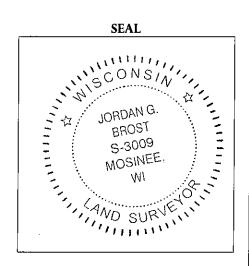

SHEET 2 OF 2

ADAMS COUNTY COUNTY CORNER NO: 63

ROMPORTOL ID: 41507180000


PUBLIC LAND SURVEY MONUMENT RECORD

CALCULATED POSITION TYPE OF MONUMENT: ADAMS COUNTY COORDINATES, NAD 83 (2007) N. 148776.548 E. 562609.584 __ DATUM_ **ELEVATION-_** 04/01/2021 FIELD WORK DATE:


BASIS FOR MONUMENT LOCATION

2015 - PLS 2038 FOUND HARRISON MONUMENT AND SET 4 NEW TIES PRIOR TO HIGHWAY CONSTRUCTION.

2021 - PLS 2675 FOUND NO MONUMENT DUE TO HIGHWAY CONSTRUCTION BUT FOUND 4 TIES. CALCULATED POSITION BY DISTANCE - DISTANCE INTERSECTION FROM THE NORTHWEST, NORTHEAST, SOUTHEAST AND SOUTHWEST TIES AND AVERAGED THE SOLUTIONS. ACCEPTED THE CALCULATED POSITION AS THE CORNER LOCATION. NO MONUMENT WAS SET AT THE TIME OF SURVEY.

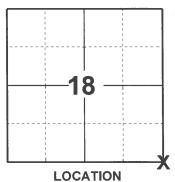

(INDICATE CORNER BY "X")

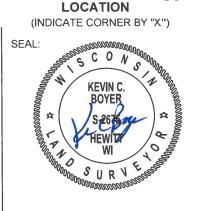

DATA SHOWN HERE ON THIS TIE SHEET IS CORRECT AND COMPLETE TO THE BEST OF MY KNOWLEDGE AND BELIEF.

PROFESSIONAL LAND SURVEYOR

DATE

-TIE SKETCH

NOTE: CORNER LANDS 3.7'± NORTH OF THE CENTERLINE OF STH 82.



MIXED WOODS FIFLD STH 82

FIFI D

FOUND WISDOT ALUMINUM CAP IN CONCRETE

CALCULATED CORNER POSITION

VINYL "T" POST

U. S. PUBLIC LAND SURVEY MONUMENT RECORD

	0. 3. TOBLIC	LAND JOKY	LI MONOMENT	KL COKD
				MADE A
	INSTRUCTIONS:	This record shall include all of the	show the location of th following nine element	s (a through i).
(a)	Identify the corner by reference to the U.S. public land survey system.			
	O = Corner monument restored.			
				7:
				1
			1 1	
	WISDOT # 1430-	01-75	1	
	467+41.27		T15N, F	RTE
		manument avidence	ems County	J, WI
(b)	Describe any record evidence, any other material evidence	ou considered, and	Mueruer the monument wa	is round of praces.
	I found a Ho	arrison mo	nument and	Tied prior
	to reconstru	iction of	SIH 82	Dica sat
	I found the in concrete	existing re	ference 11es	, DISC ser
	in concrete	Stating	Wisconsin C	separ imaci 7
	Transportation,	Po not	2157016	
(c)	In the plan view drawing beli the location is within a mun	icipality, to at lea	ist 2 witness monuments.	. (WITHESS MOHUMETTES
	shall be made of concrete, n Describe witness mon	uments.		u
(d)	Show a plan view drawing depicting the relevant		Adams Co.	inty
1	monuments and reference ties which is sufficient in detail to enable accurate relocation of the corner monument if the	l n	Adams Co. Coordinate NAO 19830	System 2011)
	corner monument is disturbed Indicate north.		1	U 148809.84
4	al 14000 as /	050	. 0	E 562643.46
14	N 148811.20 - E 562572.37	.63.	47.46	
,	Set Berntse	1 Survey	-/	776.52
(7 - marker spi	ke	1	Hwy 8a
-		790 4	1/ 48	
	Disc in Conc.	46.	74,	
)		
	W 148737.03		0	

€ 562584.58

N 148738.97 E 562641.52 (e) Describe any material discrepancy between the location of the corner as restored or reestablished and the location of that corner as previously restored or reestablished by distance and direction. Show the discrepancy on the plan view drawing under (d), above. Show the distances between the corner as previously restored or reestablished and (1) the corner as restored or reestablished, and (2) to at least 2 of the witness monuments shown on the drawing in (d), above.

No Discrepancy

(f) Was the corner restored through acceptance of (1) an obliterated evidence location, or, (2) a found perpetuated location?

I accepted the found Corner

(g&h) Was the corner reestablished through lost corner proportionate methods? If so, show the method, including the directions and distances to other public land survey corners used as evidence or used for proportioning in determining the corner location?

(i) I. An Hong Tr Alt (type or print name) dertify that the corner location shown on this record was determined by me or under my direction and control and that this U.S. Public Land Survey Monument Record is correct and complete to the best of my knowledge and belief.

7-6-15

Cianatura

Affix Land Surveyor Seal

ANTHONY J.

ALT

S-2038

MADISON

WI

ORDINATION

WI

ORDINATION

WI

ORDINATION

WI

ORDINATION

MADISON

MADISON

WI

ORDINATION

MADISON

MADI

140001.DH