15 TOWN

ADAMS COUNTY COUNTY CORNER NO: 71

ROMPORTOL ID: 41507140000

PUBLIC LAND SURVEY MONUMENT RECORD

HARRISON TYPE OF MONUMENT: ADAMS COUNTY COORDINATES, NAD 83 (2007) N. 148797.745 E. 583648.846 - — — __ DATUM___- — — ELEVATION-

FIELD WORK DATE: 03/10/2021


BASIS FOR MONUMENT LOCATION

1974 - PLS 417 USED EAST WEST FENCE LINES AND RAN TRAVERSE OF SECTIONS 12 AND 13 TO DETERMINE SEARCH AREA, FOUND RAILROAD SPIKE IN THE CENTER OF 2ND AVE AND REPLACED WITH HARRISON MONUMENT.

2021 - PLS 2675 FOUND HARRISON MONUMENT 6" BELOW THE ROAD SURFACE AND 2 TIES. THE MONUMENT AGREES WITH BOTH TIES. ACCEPTED THE HARRISON MONUMENT AS THE CORNER LOCATION. SET 3 NEW TIES AND MEASURED TO THE EXISTING TIES.



(INDICATE CORNER BY "X")

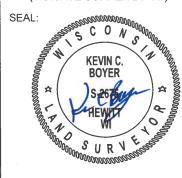

DATA SHOWN HERE ON THIS TIE SHEET IS CORRECT AND COMPLETE TO THE BEST OF MY KNOWLEDGE AND BELIEF.

PROFESSIONAL LAND SURVEYOR 21 DATE

-TIE SKETCH

NOTE: CORNER LANDS ON THE CENTERLINE OF 2ND AVE.

RAVINE



SET 3/4" x 18" IRON REBAR, 1.50#/FT


FOUND 3/4" IRON ROD

FOUND 2-3/8" O.D. IRON PIPE

FOUND HARRISON MONUMENT

STEEL FENCE POST

VINYL "T" POST

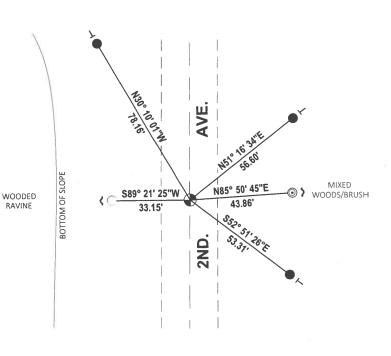

CORNER NO. 353 ADAMS COUNTY 13 SECTION Survey Monument Record IS N TOWN TYPE OF MONUMENT: HARRISON TE RANGE STATE PLANE COORDINATES: N. ELEVATION - M.S.L. DATUM: _ THETA ANGLE: FIELD BOOK: Clip sheets PAGE BASIS FOR MONUMENT LOCATION (Use reverse side if necessary) Show info such as: History of corner, with reference to Vol. and pg, dates, surveyor; exact description of monument replaced; if location computed, by taped or EDM traverse; landowner LOCATION (Indicated by 'X') SEAL: remarks, etc. Location determined by computed coordinates from an extensive traverse connecting all of Sections 12-13. Existing East-West fence lines. R.R. Spike found in center of 2nd Ave. -SAYLER replaced with Harrison Monument. Winneconn**e** No probing due to large amount of Wisconsin fill in road. CORNER O.K. 10.28-76 RN-SS CERTIFIED CORRECT: Registered Land Survey 1/15/ DATE: __ TIE SKETCH TWIN 10" (Show at least four ties) W. PINE GONE 06" FENCE POSTS OFF 33.00' IRON PIPE, 6" ABOVE GROUND EXISTING F.89, J New 3/4", RON ROD 6"Blk Oct /87 O BOTTLE CAP IN 18" OAK AT

CHEST HIEGHT.

MAINTENANCE RECORD

Date	init.	Remarks
12-30-81	TH- NJ !	MON+TIES O.K
2-3-86	GR- 55	11 11
5-8-91	JG-64	i il il
2-12-96	55	OK
2-28-01	JG	OK
3-29-06	CPR	2-NEW TIES
- 10 1		