# OT ADAMS COUNTY COUNTY CORNER NO: 79

ROMPORTOL ID: 41507232000

# PUBLIC LAND SURVEY MONUMENT RECORD


**HARRISON** TYPE OF MONUMENT: ADAMS COUNTY COORDINATES, NAD 83 (2007) N. **146159.570** E. 583640.574 ELEVATION- - - DATUM

FIELD WORK DATE:\_ 04/01/2021


#### BASIS FOR MONUMENT LOCATION

1979 - PLS 1478 FOUND NO EVIDENCE OF EXISTING MONUMENTATION OR TIES. SET HARRISON MONUMENT ON LINE AND EQUIDISTANT BETWEEN ADJACENT SECTION CORNERS.

2021 - PLS 2675 FOUND HARRISON 2" BELOW ROAD SURFACE AND 2 WITNESS TREES. MONUMENT AGREES WITH BOTH WITNESS TREES. ACCEPTED THE HARRISON MONUMENT AS THE CORNER LOCATION. SET 2 NEW TIES AND MEASURED TO 2 FOUND PROPERTY CORNERS AND THE EXISTING WITNESS TREES.

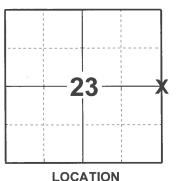

(INDICATE CORNER BY "X")

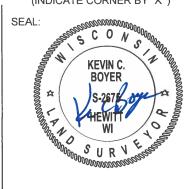

DATA SHOWN HERE ON THIS TIE SHEET IS CORRECT AND COMPLETE TO THE BEST OF MY KNOWLEDGE AND BELIEF.


PROFESSIONAL LAND SURVEYOR

#### -TIE SKETCH

NOTE: CORNER LANDS 8.3'± EAST OF THE CENTERLINE OF 2ND AVE.



- SET 3/4" x 18" IRON REBAR, 1.50#/FT
- FOUND 3/4" IRON ROD
- FOUND HARRISON MONUMENT
- STEEL FENCE POST
- VINYL "T" POST
- WITNESS TREE

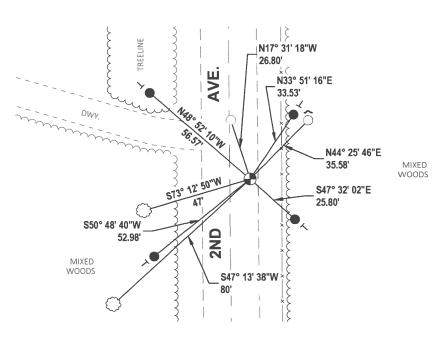

### Government Land Corner Certificate CORNER NO. \_\_County SECTION TYPE OF MONUMENT: Harrison 15 TOWN STATE PLANE COORDINATES: RANGE ELEVATION - M.S.L. DATUM: \_ THETA ANGLE: \_ 57 \_\_\_\_ PAGE 104 FIELD BOOK: \_\_\_\_ DRAWN BY: N.J. BASIS FOR MONUMENT LOCATION Show info such as: History of corner, with reference to Vol. and pg., dates, surveyor; exact description of monument replaced; if location computed, by taped or EDM traverse; landowner remarks, etc. (Use reverse side if necessary) LOCATION (Indicated by 'X') SEAL: Set monument equidistant and on line between adjacent section corners. No record of any monumentation subsequent to the original was found. No evidence of any monumentation subsequent to the original was found. Excavation was not made due to previous road construction. DATA SHOWN HERE ON CERTIFIED CORRECT: Registered Land Strveyor 10-11-79 DATE: \_\_\_ TIE SKETCH Show at least four ties, also fence lines, roads, topo, size and type of witness trees' and if off road - best way to arrive at corner. 1991 - 5"CEDAR Remnants of -x-x-x 54 Fence 7" Bur Oak/BT

## MAINTENANCE RECORD

DATE	BY WHOM	REMARKS
12-29-81	TH - NJ	MON O.K.
2-3-86	GR-SS	ii ii
5-8-91	J6-55	" / New TIE
2-12-96	55	0.K.
3-02-01	S-MH	ALL OK
8-7-06	JG	DK.
2-18-11	55	K
		·
		Σ,