

PUBLIC LAND SURVEY MONUMENT RECORD

TYPE OF MONUMENT: HARRISON
ADAMS COUNTY COORDINATES, NAD 83 (2007)

N. 143491.856

E. 565281.645


ELEVATION- _____ DATUM _____

FIELD WORK DATE: 04/07/2021

BASIS FOR MONUMENT LOCATION

1976 - PLS 922 FOUND STONE (18" HIGH, 6" BASE WITH POINTED TOP) SET BY M.C. SMITH IN 1919. FIT M.C. SMITH'S BEARING TREE AND WITNESS BOULDER. STONE FITS WELL WITH EDM TRAVERSE OF SECTION.

2021 - PLS 2675 FOUND HARRISON MONUMENT FLUSH WITH GROUND, 1 TIE AND 4 WITNESSES. THE MONUMENT AGREES WITH ALL 4 WITNESSES. TIE IS 3' SHORT OF RECORDED DISTANCE. ACCEPTED HARRISON MONUMENT AS THE CORNER LOCATION. SET 3 NEW TIES AND MEASURED TO THE EXISTING TIE AND WITNESSES.

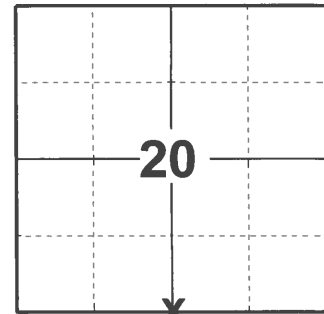

LOCATION

(INDICATE CORNER BY "X")

SEAL:




DATA SHOWN HERE ON THIS TIE SHEET IS CORRECT AND COMPLETE TO THE BEST OF MY KNOWLEDGE AND BELIEF.

PROFESSIONAL LAND SURVEYOR


DATE 5/19/21

- TIE SKETCH

NOTE: CORNER LANDS ON THE EDGE BETWEEN A PINE PLANTATION TO THE NORTH AND HARDWOODS TO THE SOUTH.

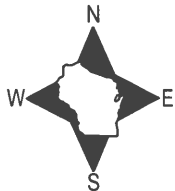

PINE PLANTATION

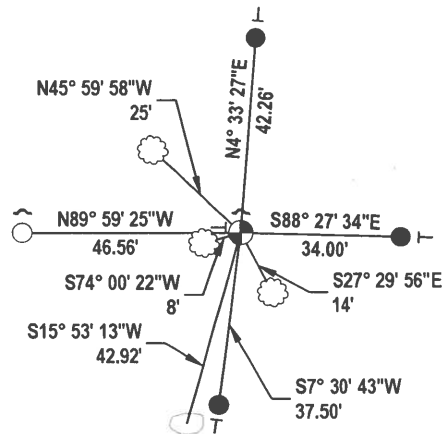

HARDWOODS

- SET 3/4" x 18" IRON REBAR, 1.50#/FT
- FOUND 3/4" IRON ROD
- FOUND HARRISON MONUMENT
- ~ STEEL FENCE POST
- VINYL "T" POST
- ☁ WITNESS TREE
- WITNESS BOULDER

ADAMS COUNTY

Survey Monument Record

CORNER NO. 854 (84)
 SECTION 29
 TOWN 15N
 RANGE 7E


TYPE OF MONUMENT: STONE & 3/4" X 24" IRON BAR, HARRISON TO BE SET SPRING 1976

STATE PLANE COORDINATES: N _____
 E _____

ELEVATION — M.S.L. DATUM: _____


THETA ANGLE: _____

FIELD BOOK: _____ PAGE _____

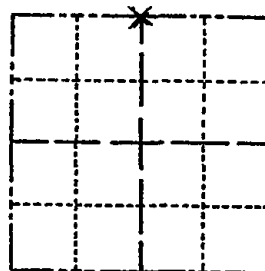

LOCATION
 (Indicated by 'X')

SEAL:

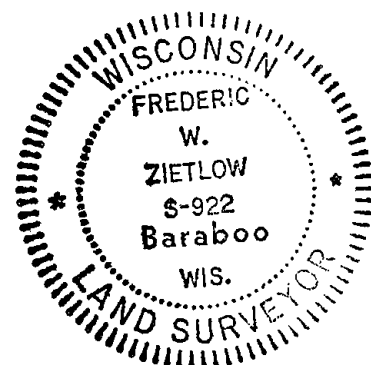

BASIS FOR MONUMENT LOCATION

(Use reverse side if necessary)

Show info such as: History of corner, with reference to Vol. and pg. dates, surveyor; exact description of monument replaced; if location computed, by taped or EDM traverse; landowner remarks, etc.

FOUND STONE (18" HIGH, 6" BASE, WITH POINTED TOP) SET BY M.C. SMITH IN 1919. FIT M.C. SMITH BEARING TREE & WITNESS BOULDER, ALSO FIT E.D.M. TRAVERSE OF SECTION GOOD

MAINTENANCE RECORD

Date	Init.	Remarks
12-29-81	TH-NJ	Mon O.K.
3-3-86	GR	" "
6-7-91	JG-SS	OK
5-14-96	SS	"
2-27-01	MD-JB	ALL OK
8-8-06	JG	OK
7-15-11	SS	OK

CERTIFIED CORRECT:

Frederic W. Zietlow

Registered Land Surveyor

DATE: 1-15-76

TIE SKETCH

(Show at least four ties)

