ADAMS COUNTY COUNTY COUNTY CORNER NO: 92

ROMPORTOL ID: 41507240020

PUBLIC LAND SURVEY MONUMENT RECORD

3/4" IRON ROD TYPE OF MONUMENT:_ ADAMS COUNTY COORDINATES, NAD 83 (2007)

N. 143507.214

E. 586297.258


ELEVATION- - - DATUM

04/05/2021 FIELD WORK DATE:


BASIS FOR MONUMENT LOCATION

1976 - PLS 1103 RAN EDM/T2 TRAVERSE AROUND SECTION 25 TO DETERMINE SEARCH AREA. FOUND NO EVIDENCE OF ORIGINAL CORNER. SET HARRISON MONUMENT BY SINGLE PROPORTION MEASURE ON LINE BETWEEN ADJACENT SECTION CORNERS.

2021 - PLS 2675 FOUND 3/4" IRON ROD 20" BELOW GROUND SURFACE AND 4 TIES. THE MONUMENT AGREES WITH ALL 4 TIES. ACCEPTED 3/4" IRON ROD AS THE CORNER LOCATION. SET 2 NEW TIES AND MEASURED TO THE EXISTING TIES.

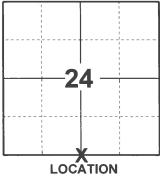

(INDICATE CORNER BY "X")

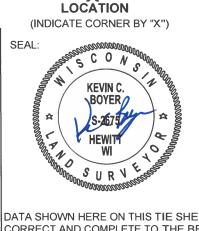

DATA SHOWN HERE ON THIS TIE SHEET IS CORRECT AND COMPLETE TO THE BEST OF MY KNOWLEDGE AND BELIEF.


PROFESSIONAL LAND SURVEYOR

2 DATE

-TIE SKETCH

NOTE: MONUMENT IS 20" BELOW GROUND SURFACE.



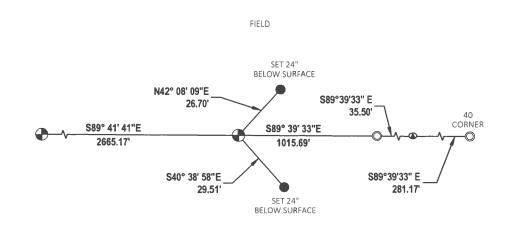

FIELD

- SET 3/4" x 18" IRON REBAR, 1.50#/FT
- FOUND RAILROAD SPIKE
- FOUND 1-1/4" O.D. IRON PIPE
- FOUND 3/4" IRON ROD


ADAMS COUNTY

Survey Monument Record

TYPE OF MONUMENT: HARRISON

STATE PLANE COORDINATES: N______

ELEVATION — M.S.L. DATUM:

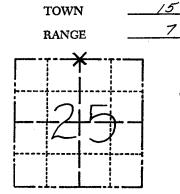

CORNER NO. .

SECTION

25

LOCATION (Indicated by 'X')

SEAL:

BASIS FOR MONUMENT LOCATION

(Use reverse side if necessary)

Show info such as: History of corner, with reference to Vol. and pg, dates, surveyor; exact description of monument replaced; if location computed, by taped or EDM traverse; landowner remarks, etc.

Ran EDM/T2 traverse around Section 25 to determine search area for investigation.

Could find no evidence of the original corner, remonumentation, or any bearing trees.

Re-established corner by single proportionate measure on line between adjacent section corners. MAINTENANCE RECORD

Date Init. Remarks

7-19-86 Gl-55 OK

5-3-91 JG-55 /-GONE MON. OK NO THES AVAILABLE

2-12-96 SS HAR. & STEEL POST/SIGN REMAIN
ALL OTHER GONE

8-2-01 JG-MH SEE ATTACHED SHEET/CARROL SURVEY

8-1-06 JG 11 11

DALE C.
HAGEN
S-1103
Wisconsin Rapids,
Wis.

CERTIFIED CORRECT;

Registered Land Surveyor
DATE: 12-2-76

TIE SKETCH

(Show at least four ties)

NOTE

Ties in trees to nail in disc.

SEE CSM 3777 ATVACUED

'n

\$ 1000 W. OF

2665.10' to 2665.10'
Northwest corner Northeast

2665.10' to Northeast corner FELM GONE INCOMP (NO BT)

FIELD

ADAMS COUNTY CORNER NO. Survey Monument Record 25 **SECTION** 15 TYPE OF MONUMENT: HARRISON TOWN STATE PLANE COORDINATES: N. RANGE ELEVATION — M.S.L. DATUM: THETA ANGLE: _ FIELD BOOK: ___ *38* PAGE _ BASIS FOR MONUMENT LOCATION (Use reverse side if necessary) Show info such as: History of corner, with reference to Vol. and pg, dates, surveyor; exact description of monument replaced; if location computed, by taped or EDM traverse; landowner LOCATION (Indicated by 'X') SEAL: remarks, etc. OALE C. HAGEN S-1103 Wisconsin Repids, Wis. Ran EDM/T2 traverse around Section 25 to determine search area for investigation. Could find no evidence of the original corner, remonumentation, or any bearing trees. Re-established corner by single proportionate measure on line between adjacent section corners MAINTENANCE RECORD Date Init. Remarks 7-19-86 GESS oK-56-55 NO TIES AVAILABLE CERTIFIED CORRECT REMOVED BY LANDOWNER Registered Land Surveyor ADAMS COUNTY CSM 3777 DATE: TIE SKETCH (Show at least four ties) NOTE Ties in trees to nail in disc. S 1/4 COR. 24-15-7 1015,72 "ד ות2665 35.56 1051.28 281.16' **FORTY** N 89-41-59 W 1332.44' COR.

FIELD

O PEN