OT RANGE ADAMS COUNTY COUNTY CORNER NO: 95

ROMPORTOL ID: 41507302000

PUBLIC LAND SURVEY MONUMENT RECORD

HARRISON TYPE OF MONUMENT: ADAMS COUNTY COORDINATES, NAD 83 (2007)

N. 140840.689

E. 562685.776


_ DATUM___- -------ELEVATION-

04/27/2021 FIELD WORK DATE:


BASIS FOR MONUMENT LOCATION

1976 - PLS 922 FOUND MOUND AND TRIANGULAR FORMATION OF STONES. NO RECORD OF THIS IN ADAMS COUNTY SURVEY RECORDS. FIT EDM TRAVERSE OF SECTION GOOD.

2021 - PLS 2675 FOUND HARRISON MONUMENT FLUSH WITH GROUND SURFACE, 1 TIE AND 3 WITNESSES. MONUMENT AGREES WITH THE TIE AND WITNESSES, ACCEPTED THE HARRISON MONUMENT AS THE CORNER LOCATION. SET 3 NEW TIES AND MEASURED TO THE EXISTING TIE AND WITNESSES.

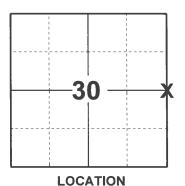

(INDICATE CORNER BY "X")

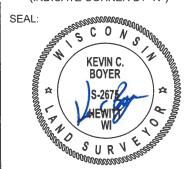

DATA SHOWN HERE ON THIS TIE SHEET IS CORRECT AND COMPLETE TO THE BEST OF MY KNOWLEDGE AND BELIEF.


PROFESSIONAL LAND SURVEYOR

-TIE SKETCH

NOTE: CORNER LANDS 300'± EAST OF 5TH LANE.



- O FOUND 3/4" IRON ROD
- SET 3/4" x 18" IRON REBAR, 1.50#/FT
- FOUND HARRISON MONUMENT
- STEEL FENCE POST
- VINYL "T" POST
- WITNESS STONE

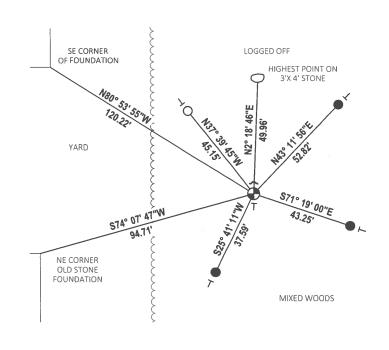

Government Land Corner Certificate


ADAMS	County	y
TYPE OF MONUMENT:H		
STATE PLANE COORDINAT	ES: N	
	F	
ELEVATION - M.S.L. DAT	TUM:	<u></u>
THETA ANGLE:		<u> </u>
FIELD BOOK:	PAGE	·
DRAWN BY: LOWEF	····	

BASIS FOR MONUMENT LOCATION

Show info such as: History of corner, with reference to Vol. and pg., dates, surveyor; exact description of monument replaced; if location computed, by taped or EDM traverse; landowner remarks, etc. (Use reverse side if necessary)

RESEARCHED ADAMS COUNTY SURVEY RECORDS & NO RESURVEYS WERE ON FILE WHICH WERE PERTINENT TO THIS CORNER. THIS CORNER FALLS IN A LARGE CULTIVATED FIELD & THERE IS NO REMAINING EVIDENCE AS TO WHERE THE ORIGINAL GOU'T /4 POST WOOLD HAVE BEEN LOCATED. WE RESET THIS CORNER BY THE SINGLE PROPORTIONATE METHOD AS OUTLINED IN THE BLM. MANUAL OF INSTRUCTIONS

EDMI - THEODOLITE TRAVERSE

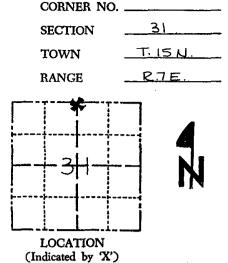

SEAL:

ZIETLOW S-922 Raraboo WIS.

DATA SHOWN HERE ON CERTIFIED CORRECT:

Registered Land Surveyor

DATE: FEBRUARY 1, 197


TIE SKETCH

Show at least four ties, also fence lines, roads, topo, size and type of witness trees' and if off road - best way to arrive at corner.

NOTE THIS IS IN A CULTIVATED AREA & THERE IS A LACK OF GOOD WITHESS OBJECTS.

MAINTENANCE RECORD

Date	Init.	Remarks	
12-28-81	TH-NS	FRR. PIVOT APPROX O.A	
2-3-86	GR 85	TIES OK - DIO NOT	
6-12-91	J6-CR	TIES OK	
SÉE TIE	1	1	
2-27-01	W17.26	ALL OK	
3-1-06	56	ak	

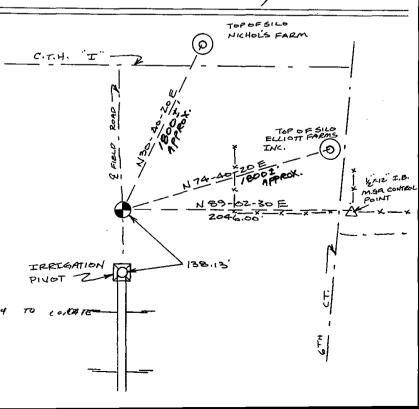

CORNER NO. 102 SECTION 30
TOWN 15N 7E
LOCATION (Indicated by X') SEAL: MARK C. CARLSON S-2021 Barriscoo, WI DATA SHOWN HERE ON CERTIFIED CORRECT: Mark Carlson Registered Land Surveyor DATE: 2-23-96
NOT TO SCALE PK South edge of blacktup WACTH I

NORTHERLY BOLT ON FLANGE OF IRRIGATION PIVOT. 3/4"ROD "40"CORNER

O TRANSFORMER PAD.

MAINTENANCE RECORD

Date Init.		Remarks	