OT ADAMS COUNTY COUNTY CORNER NO: 112

ROMPORTOL ID: 41507250020

PUBLIC LAND SURVEY MONUMENT RECORD

HARRISON TYPE OF MONUMENT: ADAMS COUNTY COORDINATES, NAD 83 (2007)

N. 138249.390

E. 586296.636


ELEVATION- - — DATUM

FIELD WORK DATE:_ 04/14/2021

BASIS FOR MONUMENT LOCATION

1976 - PLS 1103 RAN EDM/T2 TRAVERSE AROUND SECTION 25 TO DETERMINE SEARCH AREA. FOUND REMAINS OF ORIGINAL BEARING TREE IN NORTHWEST QUADRANT. EXCAVATION AT LOCATION REFERENCED TO BY BEARING TREE YIELDED NO EVIDENCE OF ORIGINAL CORNER OR REMONUMENTATION. RE-ESTABLISHED CORNER AT LOCATION INDICATED BY BEARING TREE.

2021 - PLS 2675 FOUND HARRISON MONUMENT 4" BELOW ROAD SURFACE AND 1 WITNESS. MONUMENT AGREES WITH THE WITNESS. ACCEPTED HARRISON MONUMENT AS THE CORNER LOCATION. SET 3 NEW TIES AND MEASURED TO A FOUND PROPERTY IRON AND EXISTING WITNESS.

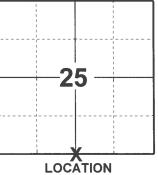

(INDICATE CORNER BY "X")



DATA SHOWN HERE ON THIS TIE SHEET IS CORRECT AND COMPLETE TO THE BEST OF MY KNOWLEDGE AND BELIEF.

PROFESSIONAL LAND SURVEYOR


19/21

- TIE SKETCH

NOTE: CORNER LANDS 1.9'± NORTH OF THE CENTERLINE OF FUR DR.



- SET 3/4" x 18" IRON REBAR, 1.50#/FT
- FOUND HARRISON MONUMENT
- FOUND 1-1/4" OD PIPE
- STEEL FENCE POST
- VINYL "T" POST
- WITNESS PEDISTAL

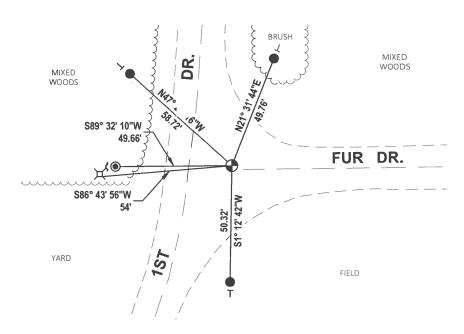

112 ADAMS COUNTY CORNER NO. _____ SECTION Survey Monument Record TOWN TYPE OF MONUMENT: ____HARRISON 7 RANGE STATE PLANE COORDINATES: N_ E ELEVATION — M.S.L. DATUM: ___ THETA ANGLE: _ FIELD BOOK: 38 PAGE /2 BASIS FOR MONUMENT LOCATION (Use reverse side if necessary) LOCATION Show info such as: History of corner, with reference to Vol. and pg, dates, surveyor; exact description of monument replaced; if location computed, by taped or EDM traverse; landowner (Indicated by 'X') SEAL: remarks, etc. DALE C. HAGEN S-1103 Wisconsin Rapids, Wis. Ran EDM/T2 traverse around Section 25 to determine search area. Found remains of original bearing tree in the Northwest Quadrant. Excavation at the location referenced by this bearing tree yielded no evidence of the original corner or any remonumentation. Re-established corner at location indicated by bearing tree. CERTIFIED CORRECT: Registered Land Surveyor DATE: TIE SKETCH (Show at least four ties) TWIN T"CHOKE NOTE Ties in trees to NEW WALL nail in I'IRON PIPE! LONE 12" CHERRY disc. K.E.I. PLUG SET IN FACE OF B.T. STUMP. AND. SIGN IN CENTER OF STUMP DND SICH ON STEEL POST #_{T150} S.E. COR AT GROWND MAINTENANCE RECORD Date Init. Remarks 12-30-81 TH-NJ Ties O.K Z-19-86 GR-SS OK JG-55 ALLOK GONE 10" BURR 2-12-96 OK 55 3-02-01 JG-MH I-NEW

3-1-06

LIG

OΚ