# OT ADAMS COUNTY COUNTY CORNER NO: 116

ROMPORTOL ID: 41507322000

## PUBLIC LAND SURVEY MONUMENT RECORD

**HARRISON** TYPE OF MONUMENT: ADAMS COUNTY COORDINATES, NAD 83 (2007)

N. **135557.642** 

E. 567906.793

ELEVATION- - - DATUM

FIELD WORK DATE:\_ 04/22/2021

#### BASIS FOR MONUMENT LOCATION

1976 - PLS 1103 RAN EDM/TRANSIT TRAVERSE AROUND SECTION 33-15-7 TO DETERMINE SEARCH AREA. FOUND NO EVIDENCE OF THE ORIGINAL CORNER OR ANY SUBSEQUENT REMONUMENTATION. SET CORNER ON LINE AND PROPORTIONAL TO ORIGINAL NOTES BETWEEN ADJACENT SECTION CORNERS.


1983- PLS 878 RAN EDM/ TRANSIT TRAVERSE AROUND SECTION 33-15-7 TO DETERMINE SEARCH AREA. FOUND NO EVIDENCE OF THE ORIGINAL CORNER OR ANY SUBSEQUENT REMONUMENTATION, SET CORNER ON LINE AND PROPORTIONAL TO ORIGINAL NOTES BETWEEN THE ADJACENT SECTION CORNERS. CORNER HAD TO BE RESET DUE TO OUR AGA MODEL 76 LASER GAVE A 5 METER ERROR IN A DISTANCE READOUT IN ONE OF THE LEGS OF THE SECTION TRAVERSE. DISREGARD ANY OTHER TIES TO THIS CORNER. CORNER WAS MOVED IN THE SPRING OF 1977.

2021 - PLS 2675 FOUND HARRISON MONUMENT FLUSH WITH GROUND SURFACE AND 2 WITNESS TREES. THE MONUMENT AGREES WITH THE EXISTING WITNESS TREES. ACCEPTED HARRISON MONUMENT AS THE CORNER LOCATION. SET 4 NEW TIES AND MEASURED TO THE EXISTING WITNESSES.



LOCATION

(INDICATE CORNER BY "X")

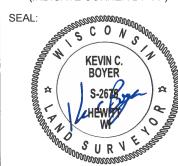

DATA SHOWN HERE ON THIS TIE SHEET IS CORRECT AND COMPLETE TO THE BEST OF MY KNOWLEDGE AND BELIEF.


PROFESSIONAL LAND SURVEYOR 21

-TIE SKETCH -

NOTE: CORNER LANDS 78'± NORTHEAST OF THE CENTERLINE OF FUR DR.



- SET 3/4" x 18" IRON REBAR, 1,50#/FT
- FOUND HARRISON MONUMENT
- VINYL "T" POST
- WITNESS TREE

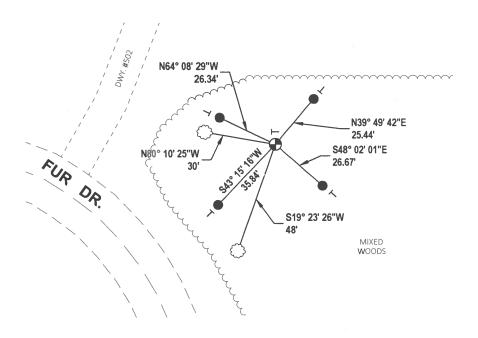

TYPE OF MONUMENT: HARRISON	CORNER NO//6
	SECTION 33
STATE PLANE COORDINATES: N	TOWN
E	RANGE
ELEVATION — M.S.L. DATUM:	<del></del>
FIELD BOOK: FILE PAGE	
DRAWN BY: LANCE HABECK	7.
	$\star$
BASIS FOR MONUMENT LOCATION	
Show info such as: History of corner, with reference to Vol.	
and pg., dates, surveyor; exact description of monument replaced; if location computed, by taped or EDM traverse; landowner remarks, etc. (Use reverse side if necessary)	LOCATION
S.	(Indicated by 'X') EAL:
Ran EDM/transit traverse around Section 33-15-7	***************
to determine search areas.	WINNECONS IN
Could find no evidence of the original corner or	
any subsequent remonumentation.	ANTHONY B. KIEDROWSKI
Set corner on line and proportional to original	S-878 Wisconsin Rapids,
notes between the adjacent section corners.	Wis.
	AL DANSE
NOTE: This corner had to be reset because	William SURVERSON
	DATA SHOWN HERE ON CERTIFIED CORRECT:
The distribution of the 1930 of the	_
this corner.Corner was moved in spring of '77. $\bar{I}$	Registered Land Surveyor
5-3-91 SS-IG 2-NEW TIES, MON OK I	DATE: 28-8-83
2-26-01-JG-OK	
TIE SKETCH 3-77-11 SS OF	
Show at least four ties, also fence lines, roads, topo, size and type of witness trees' and if off road - best way to	
arrive at corner.	
i	
	<del></del>
<del>*</del> * * * * * * * * * * * * * * * * * *	*
10"BLACK OAK OF	61'+ NEAD BUTTUE
10"BLACK OAK OF (BT) (SIGN) EST	DEAD BUT NO STILL STRUDING
10" BLACK OAK OF (ST CAN) (ST	LPOST DEAD BUT NG
(SICN) EST	LPOST DEAD BUT NG
(SIGN) EST	DEAD BUTINGS STILL STRUCTURE  ORTH 105.06 > ET (BT)  45.91 DEAD BUTINGS  BUT STRUCTURE  (BT)  ORTH 105.06 > ET (BT)
(SIGN) EST	DEAD BUTINGS STILL STRUPPING STR
SIGN) END STEED STEED IN NO.	DEAD BUTINGS STILL STANDING STANDING STILL STANDING ST
(SIGN) EST	DEAD BUTING STILL STANDING STANDING STILL STANDING
SIGN) END STEED STEED IN NO.	DEAD BUTINGS STILL STANDING STILL STANDING STILL STANDING STILL STANDING STILL STANDING STILL STANDING
SIGN) END STEED STEED IN NO.	DEAD BUT NG SATUSTANDING SATUSTANDING SATUST

### MAINTENANCE RECORD

DATE	BY WHOM	REMARKS
·		
<del></del>		

Government Land Corner Certificate	•	
ADAMS County	CORNER NO.	11
TYPE OF MONUMENT HARRISON	SECTION	3
STATE PLANE COORDINATES: N	TOWN	15
E E	RANGE	7
ELEVATION - M.S.L. DATUM: THETA ANGLE:	)	
EIEI D BOOK		
DRAWN BY: LANCE HABECK		
	*	
BASIS FOR MONUMENT LOCATION		
Show info such as: History of corresponds to the such as the such		
and pg., dates, surveyor; exact description of monument		
Show info such as: History of corner, with reference to Vol: and pg., dates, surveyor; exact description of monument replaced; if location computed, by taped or EDM traverse; landowner remarks, etc. (Use reverse side mecessary)	LOCATION	
SEA	AL: (Indicated by X')	
Ran EDM/transite traverse around Section 33-15-7		
vo de cenimine Search Arbae	MINGCON	
Could find no evidence of the original corner or	ANTHONY B. KIEDROWSKI S-878	
any subsequent remonumentation.	ANTHONY B.	
Set componer live	KIEDROWSKI S-878	
Set corner on line and proportional to original notes between the adjacent section corners.	Wisconsin Rapids,	
dayacent section corners.	Wis. OS	
NOTE. This course		
NOIE: This corner had to be reset because our AGA Model 76 Laser gave a five meter error DA	JAMES URVINING	-
" a distalle regardit in one of the load of the	TA SHOWN HERE ON RTIFIED CORRECT:	
section traverse. Dispendent any other time to	hythony B Keeper	
Reg	istered Land Surveyor	7
The sched Aug 13, 1983 K. Carlson DA	TE: 28-8-83	•
TIE SKETCH	5.7	_
how at least four ties, also fence lines, roads, topo, size	Z-3-86 GR	_ \$
nd type of witness trees' and if off road - best way to rrive at corner.	OK	
* * * * *	×	
10" BLACK OAK (BT) 6	'±	
ۥ J30	7"ELM	
C FUR	OK (37)	
PRIVE	105.06	
	33	
	SpK/cm C	01
SSX	6 Nord	VC •
record this	Jan 4"NORWAY	- 
0 Wigognain Statutes.	5 ( ) ( ) ( ) ( ) ( ) ( )	J
Churchan 215	DE ITAL	
ADAMS COUNTY SURVEYOR	PINOLANI	
M 33'±		
	4"NORWAY PIN	

### 950 ADAMS COUNTY CORNER NO. SECTION Survey Monument Record TOWN TYPE OF MONUMENT: Harrison STATE PLANE COORDINATES: N. RANGE ELEVATION - M.S.L. DATUM: THETA ANGLE: \_ 38 FIELD BOOK: PAGE BASIS FOR MONUMENT LOCATION (Use reverse side if necessary) LOCATION Show info such as: History of corner, with reference to Vol. and pg, dates, surveyor; exact description of monument replaced; if location computed, by taped or EDM traverse; landowner (Indicated by 'X') SEAL: remarks, etc. Ran EDM/transit traverse around Section 33-15-7 to determine search areas. Could find no evidence of the original corner or DALE C. any subsequent remonumentation. HAGEN \$-1103 Set corner on line and proportional to original Wisconsin Rapids, notes between the adjacent Section corners. CERTIFIED CORRECT: Registered Land Survey 6-1-1976 DATE: TIE SKETCH (Show at least four ties) NOTE Ties in trees to nail in disc. 112.95 10" BLACK SAY () 25'£

MAINTENANCE RECORD

Date	leit.	Remarks
12-28-81	TH-NJ	0.K
	_	
ALL		
····	<del></del>	
A-174		