OT ADAMS COUNTY CORNER NO: 118

ROMPORTOL ID: 41507342000

PUBLIC LAND SURVEY MONUMENT RECORD

TYPE OF MONUMENT: ADAMS COUNTY ALUMINUM CAP IN CONCRETE ADAMS COUNTY COORDINATES, NAD 83 (2007)

N. 135598.885

E. 578407.248


ELEVATION- - - DATUM

04/15/2021 FIELD WORK DATE:


BASIS FOR MONUMENT LOCATION

1976 - PLS 1103 RAN EDM TRANSIT TRAVERSE AROUND SECTION 34 TO EAST QUARTER CORNER OF SECTION 33, FOUND 5" DIAMETER CONCRETE MONUMENT WITH LEAD CAP. BELIEVE CAP WAS SET BY RAY PHILLIPS, NO RECORDS FOUND TO VERIFY. ACCEPTED MONUMENT AS CORNER LOCATION.

2021 - PLS 2675 FOUND ADAMS COUNTY ALUMINUM CAP IN CONCRETE 6" ABOVE GROUND SURFACE AND 2 WITNESSES. MONUMENT AGREES WITH ALL 3 WITNESSES. ACCEPTED THE ADAMS COUNTY ALUMINUM CAP IN CONCRETE AS THE CORNER LOCATION. SET 4 NEW TIES AND MEASURED TO THE EXISTING 2 WITNESSES.

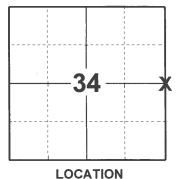

(INDICATE CORNER BY "X")

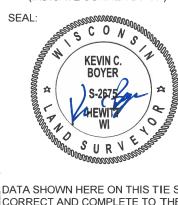

DATA SHOWN HERE ON THIS TIE SHEET IS CORRECT AND COMPLETE TO THE BEST OF MY KNOWLEDGE AND BELIEF.

PROFESSIONAL LAND SURVEYOR


21 DATE

- TIE SKETCH

NOTE: CORNER LANDS 1.6'± NORTH OF FENCE LINE.



- SET 3/4" x 18" IRON REBAR, 1.50#/FT
- FOUND ADAMS COUNTY ALUMINUM CAP IN CONCRETE
- VINYL "T" POST
- WITNESS TREE

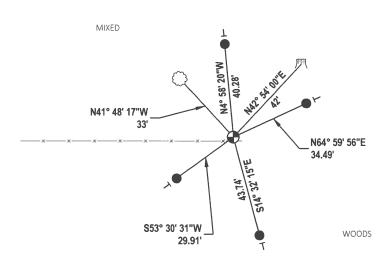

ADAMS COUNTY	corner no. <u>951</u>
Survey Monument Record	SECTION 34
TYPE OF MONUMENT: 3" Dia. Concrete Monument with Cap	TOWN
STATE PLANE COORDINATES: N	RANGE Z
E	
ELEVATION — M.S.L. DATUM:	
FIELD BOOK: 38 PAGE 3	3/1 . 7.
	N
BASIS FOR MONUMENT LOCATION	
(Use reverse side if necessary)	
Show info such as: History of corner, with reference to Vol.	LOCATION
and pg, dates, surveyor; exact description of monument replaced; if location computed, by taped or EDM traverse; landowner	SEAL: (Indicated by 'X')
remarks, etc.	. A LÁŽI POR.
Ran EDM/transit traverse around Section 34 and to East Quarter corner of Section 33.	DALE C. HAGEN S-1103 Wisconsin Rapids, Wis.
to East Quarter Corner of Section 33.	Sully Strain
Found 5" Diameter Concrete Monument with lead cap	DALE C. HAGEN
with 'Adams County' and 'Do Not Disturb' on top.	S-1103 ♣
Believed set by Ray Phillips, previous Adams	Wisconsin Rapids, Wis.
County Surveyor, but as of now, no records to verify this belief have been found.	12.
·	
A 4-3	SURVINIE
Accepted monument as found and did not replace, because the monument is in excellent shape.	W. S. O. K. S.
Accepted monument as found and did not replace, because the monument is in excellent shape.	Manual Services
	CERTIFIED CORRECT:
	CERTIFIED CORRECT: Registered Land Surveyor
	CERTIFIED CORRECT:
	CERTIFIED CORRECT: Registered Land Surveyor
because the monument is in excellent shape.	CERTIFIED CORRECT: Registered Land Surveyor
TIE SKETCH	CERTIFIED CORRECT: Registered Land Surveyor
TIE SKETCH (Show at least four ties) NOTE: Ties in trees to	CERTIFIED CORRECT: Registered Land Surveyor
TIE SKETCH (Show at least four ties) NOTE: Ties in trees to	CERTIFIED CORRECT: Registered Land Surveyor
TIE SKETCH (Show at least four ties) NOTE: Ties in trees to	CERTIFIED CORRECT: Registered Land Surveyor
TIE SKETCH (Show at least four ties) NOTE: Ties in trees to	CERTIFIED CORRECT: Registered Land Surveyor
TIE SKETCH (Show at least four ties) NOTE: Ties in trees to nail in discourses and street to sign of the st	CERTIFIED CORRECT: Registered Land Surveyor
TIE SKETCH (Show at least four ties) NOTE: Ties in trees to nail in disc. of Barrenar Of Sign State Of Sign Sign Sign Sign Sign Sign Sign Sign	CERTIFIED CORRECT: Registered Land Surveyor DATE: 6-1-1976
TIE SKETCH (Show at least four ties) NOTE: Ties in trees to nail in disc. of Barrenar Of Sign State Of Sign Sign Sign Sign Sign Sign Sign Sign	CERTIFIED CORRECT: Registered Land Surveyor
THE SKETCH (Show at least four ties) NOTE: Ties in trees to nail in disc. of Back of Sign Sign Sign Sign Sign Sign Sign Sign	CERTIFIED CORRECT: Registered Land Surveyor DATE: 6-1-1976
TIE SKETCH (Show at least four ties) NOTE: Ties in trees to nail in disc. y4" BLOCK OAK/BT S' BUTTERNUT 161 Z1.Z' AVE STUMP STUMP	CERTIFIED CORRECT: Registered Land Surveyor DATE: 6-1-1976
TIE SKETCH (Show at least four ties) NOTE: Ties in trees to nail in disc y Back only of S'GN S'BUTTERNUT 'GI ZIZ' Aure S'BUTTERNUT 'GI ZIZ' Aure S'BURY ONLY ONLY ONLY ONLY ONLY ONLY ONLY ONL	CERTIFIED CORRECT: Registered Land Surveyor DATE: 6-1-1976
TIE SKETCH (Show at least four ties) NOTE: Ties in trees to nail in disc. y4" BLOCK OAK/BT S' BUTTERNUT 161 Z1.Z' AVE STUMP STUMP	CERTIFIED CORRECT: Registered Land Surveyor DATE: 6-1-1976
TIE SKETCH (Show at least four ties) NOTE: Ties in trees to nail in disc y Back only of S'GN S'BUTTERNUT 'GI ZIZ' Aure S'BUTTERNUT 'GI ZIZ' Aure S'BURY ONLY ONLY ONLY ONLY ONLY ONLY ONLY ONL	CERTIFIED CORRECT: Registered Land Surveyor DATE: 6-1-1976
TIE SKETCH (Show at least four ties) NOTE: Ties in trees to nail in disc y Back only of S'GN S'BUTTERNUT 'GI ZIZ' Aure S'BUTTERNUT 'GI ZIZ' Aure S'BURY ONLY ONLY ONLY ONLY ONLY ONLY ONLY ONL	CERTIFIED CORRECT: Registered Land Surveyor DATE: 6-1-1976

MAINTENANCE RECORD

Б.	1	
Date	Inii.	Remarks
122.01	11/11	Atomat As
12-30-81	VA-NJ	MON + TIES O.K
3-3-86	60 ==	1/
	[22] -	- OX
5-3-91.	134-55	ALL DIE
0 10 01		HAN OR
2-12-96	SS	OK
10-22-01	.75	
	<u>کک- ۲</u>	1 Now TIES
3-1-06	TI	0/4
- 00	06	UK