36 SECTION 15 TOWN 07 RANGE

ADAMS COUNTY

COUNTY CORNER NO: 120

ROMPORTOL ID: 41507362000

PUBLIC LAND SURVEY MONUMENT RECORD

TYPE OF MONUMENT: 2 3/8" OD IRON PIPE W/BRASS CAP
ADAMS COUNTY COORDINATES, NAD 83 (2007)

N. 135565.829

E. 588907.397


ELEVATION- - DATUM - - -

FIELD WORK DATE: 2/2/2017

BASIS FOR MONUMENT LOCATION

1976- PLS 823 SET 2"X30" IRON PIPE W/BRASS CAP AFTER AN EXTENSIVE CONTROL SURVEY AND STUDY OF EXISTING EVIDENCE AND USAGE OF THE AREA. THIS MONUMENT CONFORMS TO ORIGINAL GOVERNMENT SURVEYS

2017 - PLS 2994 FOUND A 2" OD IRON PIPE W/BRASS CAP 16 INCHES BELOW SURFACE. THE 2" OD IRON PIPE W/BRASS CAP AGREES WITH THE A PROPERTY IRON PER CSM 5803. ACCEPTED THE 2"OD IRON PIPE W/BRASS CAP AND SET 3 NEW TIES AND MEASURED TO THE EXISTING PROPERTY IRON.

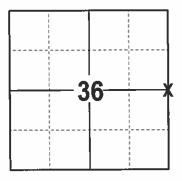

LOCATION (INDICATE CORNER BY "X")



DATA SHOWN HERE ON THIS TIE SHEET IS CORRECT AND COMPLETE TO THE BEST OF MY KNOWLEDGE AND BELIEF.

PROFESSIONAL LAND SURVEYOR

DATE 3/7/17


- TIE SKETCH



● 3/4" x 18" IRON REBAR SET, 1.50#/FT ● FOUND 3/4" IRON REBAR

◆FOUND HARRISON → VINYL "T" POST

→ STEEL "T" POST

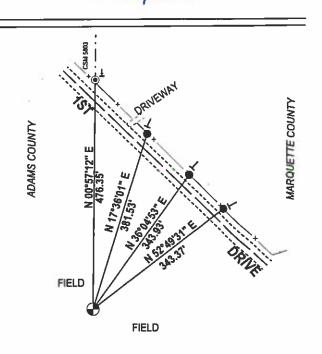

MINIMIN	LINNING D. WILLIAM	120
THINININI THE	D. WILLIAM KARNS S-823 Madison Wis. VO SURVENIMENTAL AND SURVENIMENTAL SURVENIMENTAL AND SURVENIMENTAL SURVEN	

MARQUETTE COUNTY SURVEY MONUMENT RECORDS

Town of <u>Oxford</u> Station No. A-12

Section Corner 36 ADAMS MARQUETTE 36 31 CO.

Township 15 N; Range 8 E Type of Monument: 2"x30" Iron Pipe/Bras's Cap State Plane Coordinates: N

mevation - M.S.L. Datum:

Theta Angle: _____ __ Page _ Field Book Date:

Set By: ____

BASIS FOR MONUMENT LOCATION (Show info such as: History of corner; exact description of monument; computations; remarks, etc.)

Set 2"x30" Iron Pipe with Brass Cap after an extensive control survey and study of existing evidence and usage in the area.

11-20-91 COULD LOCATE TIES (Show at least four ties) TIE SKETCH CORNER SEEM TO BE IN CULTIVATED - 1ST DRIVE KZ-JC TIES OK FIED 3-1-06 JC, - OK Gate Post N15°E, 360'± CORN FIELD Spike in 12" Double Oak East, 291.82' nument buried " down in orn field)

State of Wisconsin Marquette County

I hereby certify that this monument conforms to the original overnment surveys and has been set in accordance with the above referenced information.

Date 3-16-77

D. Welin Karna S- 823

Spike in 16" Oak S85°E, 292.39'

Registered Land Surveyor
D. William Karns, Marquette Co. Surveyor