

31 SECTION 15 TOWN 07 RANGE

ADAMS COUNTY

COUNTY CORNER NO: 123
 ROMPORTOL ID: 41507310000

PUBLIC LAND SURVEY MONUMENT RECORD

TYPE OF MONUMENT: HARRISON
 ADAMS COUNTY COORDINATES, NAD 83 (2007)

N. 132917.726

E. 562634.966


ELEVATION- --- DATUM ---

FIELD WORK DATE: 10/03/2017

BASIS FOR MONUMENT LOCATION


1977 - PLS 922 FOUND REMNANTS OF ONE ORIGINAL BEARING TREE. (DEPRESSION IN THE GROUND AND ROOTS). RE-SET CORNER FROM GOV'T TIES. SET A 30" HARRISON MONUMENT AT THE CORNER LOCATION AND TIED OUT.

2017 - PLS 2994 FOUND A HARRISON MONUMENT FLUSH WITH THE ROAD SURFACE, 3 TIES AND 1 WITNESS. THE MONUMENT AGREES WITH THE EXISTING TIES AND WITNESS. ACCEPTED THE HARRISON MONUMENT AS THE CORNER LOCATION. SET 2 NEW TIES AND MEASURED TO THE TIES AND WITNESS.

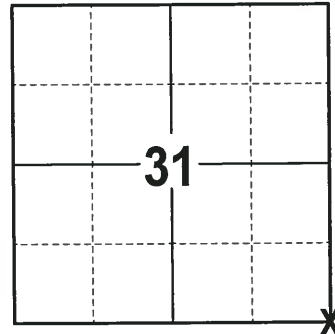

LOCATION
 (INDICATE CORNER BY "X")

SEAL:

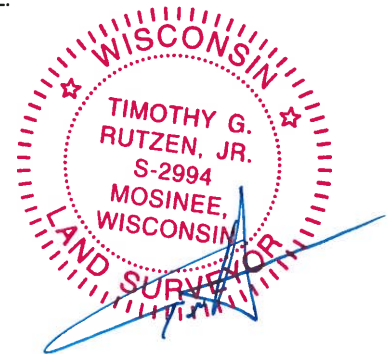


DATA SHOWN HERE ON THIS TIE SHEET IS CORRECT AND COMPLETE TO THE BEST OF MY KNOWLEDGE AND BELIEF.

PROFESSIONAL LAND SURVEYOR


DATE 12-21-17

- TIE SKETCH

NOTE: THE CORNER FALLS 5'± NORTH OF THE CENTERLINE OF GALE AVE.

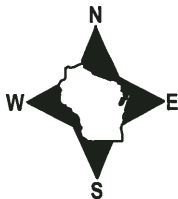

- 3/4" x 18" IRON REBAR SET, 1.50#/FT
- 7/8" IRON ROD FOUND
- ⊕ RR SPIKE FOUND
- ⊙ HARRISON FOUND
- ┌ STEEL FENCE POST
- └ VINYL "T" POST
- ☼ WITNESS TREE FOUND

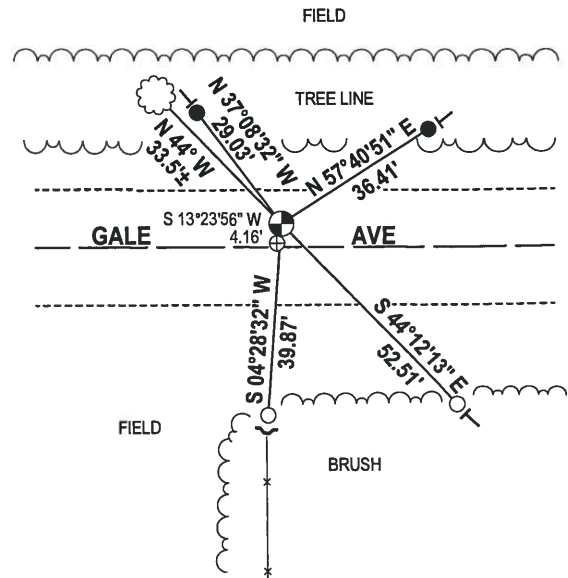

ADAMS COUNTY

Survey Monument Record

TYPE OF MONUMENT: 30" STANDARD HARRISON


STATE PLANE COORDINATES: N _____
E _____

ELEVATION — M.S.L. DATUM: _____

THETA ANGLE: _____


FIELD BOOK: 486 PAGE 54

CORNER NO. 123
SECTION 31
TOWN 15N
RANGE 7E

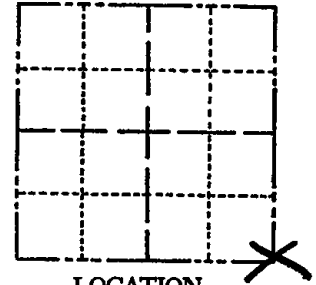

LOCATION
(Indicated by 'X')

SEAL:

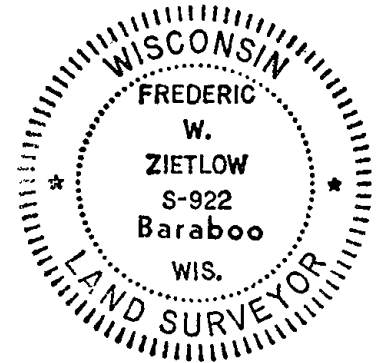

BASIS FOR MONUMENT LOCATION

(Use reverse side if necessary)

Show info such as: History of corner, with reference to Vol. and pg, dates, surveyor; exact description of monument replaced; if location computed, by taped or EDM traverse; landowner remarks, etc.

FOUND REMNANTS OF ONE ORIGINAL BEARING TREE. (DEPRESSION IN GROUND AND ROOTS.) RESET CORNER FROM GOV'T TIES

MAINTENANCE RECORD

Date	Init.	Remarks
12-28-81	TH-NJ	TIES O.K.
2-3-86	GL-SS	O.K.
5-3-91	SS-JG	ALL O.K.
2-26-01	JG	OK
1-31-06	JG	OK
12-21-11	MS	2 NEW TIES

CERTIFIED CORRECT:


Frederic W. Zietlow

Registered Land Surveyor

DATE: AUGUST 24, 1977

TIE SKETCH

(Show at least four ties)

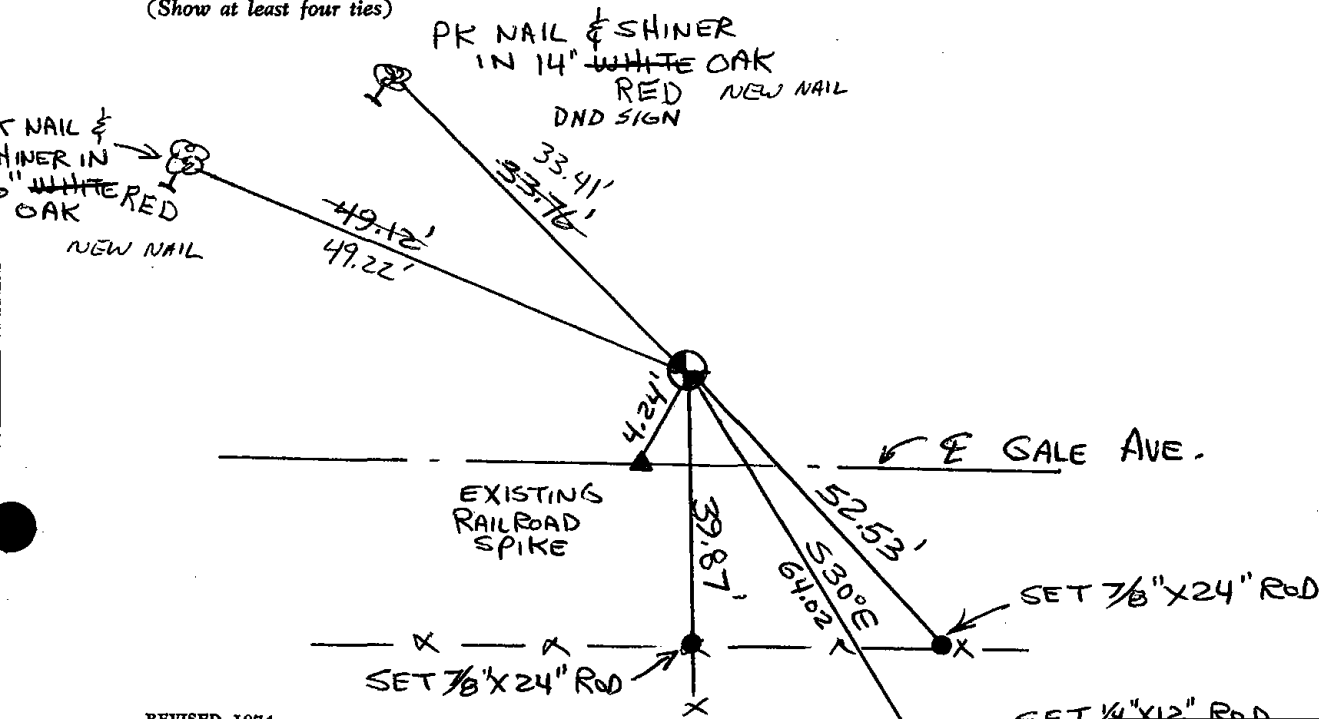

1952
1953
1954
1950
1951
1952
2050