SECTION

## OT ADAMS COUNTY

COUNTY CORNER NO: 126

ROMPORTOL ID: 41507330020

## PUBLIC LAND SURVEY MONUMENT RECORD


TYPE OF MONUMENT: 2-3/8" O.D. IRON PIPE ADAMS COUNTY COORDINATES, NAD 83 (2007) N. **132917.120** E. 570501.384 DATUM - -10/31/2017 FIELD WORK DATE:

## BASIS FOR MONUMENT LOCATION


1975 - PLS 1103 RAN EDM/TRANSIT TRAVERSE OF SOUTH AND EAST LINE OF SECTION 33-15-7. COULD FIND NO EVIDENCE OF THE ORIGINAL CORNER, REMONUMENTATION OR ACCESSORY MONUMENTS. THE BEST AVAILABLE EVIDENCE IS THE FENCE CORNER AND IT FIT THE ORIGINAL NOTES AND OCCUPATION WELL. SET A HARRISON MONUMENT AT THE FENCE CORNER AND TIED OUT.

1997 - PLS 606 THE HARRISON MARKER AT THIS LOCATION HAS BEEN TOTALLY OBLITERATED. FOUND 2 OF THE MARKER PIECES AFTER EXCAVATING. SET A 2" X30" IRON PIPE BY COORDINATE VALUE COMPUTATION FROM THE SECTION SUMMARY ON FILE FOR THIS SECTION AND TIED OUT.

2017 - PLS 2994 FOUND A 2-3/8" O.D. IRON PIPE 1" BELOW THE GROUND SURFACE AND 3 WITNESS TREES. THE MONUMENT AGREES WITH THE EXISTING WITNESS TREES. ACCEPTED THE HARRISON MONUMENT AS THE CORNER LOCATION. SET 4 NEW TIES AND MEASURED TO THE TIES AND WITNESS TREES.

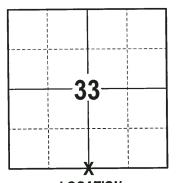

LOCATION (INDICATE CORNER BY "X")

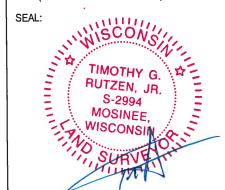

DATA SHOWN HERE ON THIS TIE SHEET IS CORRECT AND COMPLETE TO THE BEST OF MY KNOWLEDGE AND BELIEF.

PROFESSIONAL LAND SURVEYOR

- TIE SKETCH



OPEN **HARDWOODS** MIXED WOODS **FIELD FIELD** 

3/4" x 18" IRON REBAR SET, 1.50#/FT 2-3/8" O.D. IRON PIPE FOUND

VINYL "T" POST


WITNESS TREE FOUND

•	ADAMS COUNTY	CORNER NO	643
	Survey Monument Record	SECTION _	33
	TYPE OF MONUMENT: Standard Harrison	TOWN _	15
	STATE PLANE COORDINATES: N	RANGE	
	E	- T T T T T T T T T T T T T T T T T T T	٦
	ELEVATION — M.S.L. DATUM: THETA ANGLE:		
	FIELD BOOK: PAGE		
	BASIS FOR MONUMENT LOCATION		
	(Use reverse side if necessary)	<u>_</u>	_
	Show info such as: History of corner, with reference to Vol. and pg, dates, surveyor; exact description of monument replaced; if location computed, by taped or EDM traverse; landowner remarks, etc.	LOCATION (Indicated by 'X')	
	Ran EDM/transit traverse of South and East line of Section 33-15-7.	SCONSIA	<u>k</u>
	Could find no evidence of the original corner or any remonumentation or accessory monuments.  The best available evidence, the fence corner.	DALE C. HAGEN S-1103	
	The best available evidence, the fence corner, fit the original notes and occupation well.	Wisconsin Rapids, Wis.	100
	Set conner at fence corner.	SURVENING	•
	Dal	CORRECT	en
×	ALSO SEE CARROLL DTD 3/26/97 ON THE BACK) DATE: JU	ind Surveyor ne 10, 1975	
	TIE SKETCH	in those to	
		in trees to in disc.	
	4. /		4
	8"Namen GONE 8"W. Oak		4
	S. S		N
	Se of posticial social		
	FENCE GONE NEW FENCE 1000	). Ook 13t	
	CORNER POST CORNER POST	_	
	0.80		
	\ \\\\\\\\\\\\\\\\\\\\\\\\\\\\\\\\\\\\		
	CLUSTER WY CONE		

MAINTENANCE RECORD

Date	3.1	21. mwinks
12-28-81	17t-NJ	MON. O.K
3-3-86	55	TIES O.K.
5-3-91	55-16	ALL OK
11-29-95	55	TIES OK
2-27-01	JG-AH	OK
12-21-11	MS	cK.

COUNTY	CORNER NO. <u>693</u>
	SECTION 33
Survey Monument Record  TYPE OF MONUMENT: 2"×30" Iron Pipe	TOWN 15
TYPE OF MONUMENT: 2 X 30" Iron ripe.  STATE PLANE COORDINATES: N	RANGE 1E
E	RAINGE
ELEVATION — M.S.L. DATUM:	
THETA ANGLE:	
FIELD BOOK: PAGE	
	in N
BASIS FOR MONUMENT LOCATION	
(Use reverse side if necessary)	
Show info such as: History of corner, with reference to Vol.	LOCATION
and pg, dates, surveyor; exact description of monument replaced; if location computed, by taped or EDM traverse; landowner SI remarks, etc.	AL. (Indicated by 'X')
Tematas, etc.	
The Harrison marker supposed to be at	A Company of the Comp
this location has been totally obliterated	THE GON, O. T.
by others. In are excavation we found (2) of the marker pieces.	
Mining Oil or OOI water than much him consideration	JAMES J.
value computation from the Section	公 S-606 公量
Summary on file for this Section.	MAUSTON.
To the second second	
OK 1-31-06 - J6	THE NO SURVEY WHITE
	A Proposition of the Party of t
6	CARROLL S-506 MAUSTON, WIS.  SRTIFIED CORRECT
	ame Annel
<u> </u>	gistered Land Surveyor ()
т.	ATE: 1/101ch 26, 1997
TIE SKETCH	<u> </u>
	d Oak
(Show at least four ties)  12"BWN Ook to 38.82	4 00.
12! Burn Von tee	
38.82	•
30.00	ŇI
18.51	IN
(all ties and	
(all ties are) Spike nails	
Spike Mails	•
Spine mairs	
+3' 11.86	
in gate area	
Tarea	
*	
12" Bur 21.86 Oak in a 6.33	
mil Kunn. Mil	.,

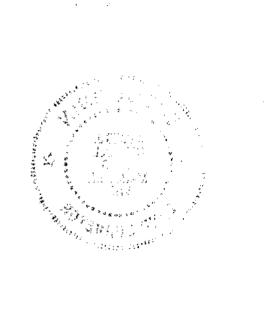

... ... ...