SECTION

OT ADAMS COUNTY

COUNTY CORNER NO: 127

ROMPORTOL ID: 41507330000

PUBLIC LAND SURVEY MONUMENT RECORD


HARRISON (BROKEN TOP) TYPE OF MONUMENT: ADAMS COUNTY COORDINATES, NAD 83 (2007) N. **132917.204** E. 573136.175 DATUM - -**ELEVATION-**

10/31/2017 FIELD WORK DATE:

BASIS FOR MONUMENT LOCATION

1975 - PLS 1103 RAN EDM/TRANSIT TRAVERSE OF SOUTH AND EAST LINE OF SECTION 33-15-7. COULD FIND NO EVIDENCE OF THE ORIGINAL CORNER OR ANY REMONUMENTATION OR ACCESSORY MONUMENTS. SET CORNER BY DOUBLING OVER THE LINE FROM THE SOUTHWEST CORNER TO THE SOUTH QUARTER CORNER. SET A STANDARD HARRISON MONUMENT AT THE CORNER LOCATION AND TIED OUT.

2017 - PLS 2994 FOUND A HARRISON MONUMENT WITH THE TOP BROKEN 24" BELOW THE SURFACE. NO TIES OR WITNESSES WERE FOUND. ACCEPTED THE HARRISON MONUMENT WITH A BROKEN TOP AS THE CORNER LOCATION. SET 4 NEW TIES AND MEASURED TO THE

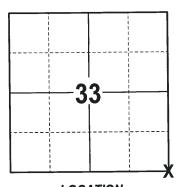

LOCATION (INDICATE CORNER BY "X")

SCON TIMOTHY G. RUTZEN, JR. S-2994 MOSINEE, WISCONSIN

DATA SHOWN HERE ON THIS TIE SHEET IS CORRECT AND COMPLETE TO THE BEST OF MY KNOWLEDGE AND BELIEF.


PROFESSIONAL LAND SURVEYOR

12-21-17 DATE

- TIE SKETCH

NOTE: THE CORNER FALLS 289'± NORTH-EAST OF THE CENTERLINE OF FUR LANE.



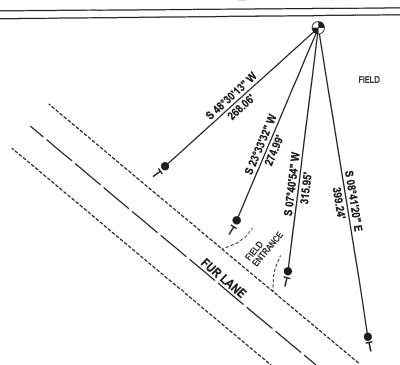

3/4" x 18" IRON REBAR SET, 1.50#/FT THARRISON (BROKEN TOP) FOUND

- VINYL "T" POST

ADAMS COUNTY	CORNER NO	692
Survey Monument Record	SECTION _	33
TYPE OF MONUMENT: Standard Harrison	TOWN _	15
STATE PLANE COORDINATES: N	RANGE _	7
<u>E</u>		7
ELEVATION — M.S.L. DATUM: THETA ANGLE:	<u> </u>	
FIELD BOOK: PAGE		
••		N
BASIS FOR MONUMENT LOCATION		1
(Use reverse side if necessary)		.
Show info such as: History of corner, with reference to Vol.	LOCATION	^
and pg, dates, surveyor; exact description of monument replaced; if location computed, by taped or EDM traverse; landowner SEAL:	(Indicated by 'X')	
remarks, etc.		
Ran EDM/transit traverse of South and East line of Section 33-15-7. Could find no evidence of the original corner or any remonumentation or accessory monuments. Set corner by doubling over line from Southwest corner to South Quarter corner.	Million Million	
of Section 33-15-7.	SCONSINI	
Could find no evidence of the original corner or	DATO.	
any remonumentation or accessory monuments.	H- 1 N S-11 3 Z	
Set councy by doubling even line from Southwest	Wisco : ads,	
Set corner by doubling over line from Southwest corner to South Quarter corner.	105	
	SURVERIN	/
TIES O.K. 2-3-86 GR-SS	A11110101010	(
TIES OR 5-3-91- JG-SS		
1' " 11-29-95 - SS CERTIFII	ED CORRECT:	
11 11 2-26-01 - 3G Registered	Land Surveyor	<u> </u>
	June 10. 19/5	
		Ē
TIE SKETCH	1	
(Show at least four ties)	}	
NOTE: The decision of		4
NOTE: Ties in trees to nail in disc.		4
	Ç.	N
FIELD FIELD	į	
Lieto		•
CONE 5721/212		
15"Ship 1 252.50"		
FIELD		
FIELD		
Hall by John Street Str	İ	
	Ĭ.	
	20	
Machine she	1	
machine sh	O _K	

=

