OS ADAMS COUNTY

COUNTY CORNER NO: 124

ROMPORTOL ID: 41705320020

PUBLIC LAND SURVEY MONUMENT RECORD


| TYPE OF MONUMENT: | | HARRISON | |
|---|--------|----------|--|
| ADAMS COUNTY COORDINATES, NAD 83 (2007) | | | |
| N. <u>192088.671</u> | | | |
| E. <u>502033.894</u> | | | |
| ELEVATION | DATUM_ | | |
| FIELD WORK DATE: 01/03/2018 | | | |

BASIS FOR MONUMENT LOCATION


1981 - PLS 1444 THIS CORNER WAS SET EQUIDISTANT AND ON A STRAIGHT LINE BETWEEN SECTION CORNERS. FOUND NO EVIDENCE FROM THE ORIGINAL CORNER OR ANY RESURVEYS. SET A HARRISON MONUMENT AT THE CORNER LOCATION AND TIED OUT.

2005 - PLS (UNKNOWN) VERIFIED THE CORNER LOCATION AND RE-TIED.

2017 - PLS 2994 FOUND A HARRISON MONUMENT 2" ABOVE THE GROUND SURFACE AND 1 WITNESS TREE. THE MONUMENT AGREES WITH THE EXISTING WITNESS TREE. ACCEPTED THE HARRISON MONUMENT AS THE CORNER LOCATION. SET 4 NEW TIES AND MEASURED TO THE TIES AND WITNESS TREE.

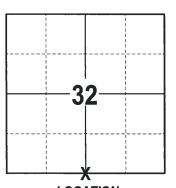

LOCATION (INDICATE CORNER BY "X")

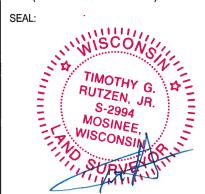

DATA SHOWN HERE ON THIS TIE SHEET IS CORRECT AND COMPLETE TO THE BEST OF MY KNOWLEDGE AND BELIEF.


PROFESSIONAL LAND SURVEYOR

2-2-18 DATE

- TIE SKETCH



FIELD

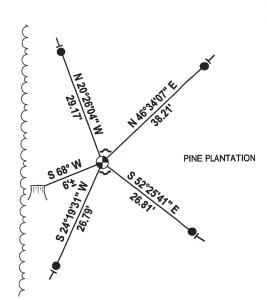


• 3/4" x 18" IRON REBAR SET, 1.50#/FT THARRISON FOUND

→ VINYL "T" POST

WITNESS TREE FOUND

| Government Land Corner Certificate | 4 |
|---|--|
| County | CORNER NO |
| TYPE OF MONUMENT: HARRISON | SECTION |
| STATE PLANE COORDINATES: N | TOWN |
| <u>F </u> | RANGE |
| ELEVATION — M.S.L. DATUM: | |
| THETA ANGLE: | |
| DRAWN BY: U J | |
| | |
| BASIS FOR MONUMENT LOCATION | |
| Show info such as: History of corner, with reference to Vol. and pg., dates, surveyor; exact description of monument | |
| replaced; if location computed, by taped or EDM traverse; landowner remarks, etc. (Use reverse side if necessary) | LOCATION (Indicated by 'X') |
| Authorities seements, etc. (436 foreign same if necessary) | SEAL: |
| | THINING CONSTANT |
| This corner was set equidistant and on a straight line between section corners. No evidence of the | |
| original corner or any resurvey corner was found. | LANCE J. HABECK |
| 1-GONE, 1-NEW 7-10-90 JG, SS | S-1444 Stevens Point, |
| 1-CONE, 2-NEW 1-11-95 JG-55 | Wis. |
| 2-60NE, 2-NEW, 4-11-00-JG | The state of the s |
| RETIED ON BACK 10-31-05-56 | SUR SUR |
| 3 10 31 02 10 31 03 2 36 | |
| | DATA SHOWN HERE ON CERTIFIED CORRECT: |
| | |
| | Registered Land Surveyor |
| | DATE: |
| | |
| TIE SKETCH | |
| Show at least four ties, also fence lines, roads, topo, size and type of witness trees' and if off road - best way to arrive at corner. | 8' JACK PINE/ 4' STUMP BT |
| TAKE WOODS TRAIL OFF CTY"Z" | RETIED ON BACK |
| IN CUT OFF AREA STAY TO THE | |
| RICHT. | GONE |
| No BT/ NEIL | BUBURE PINES |
| CTY'Z" SMALL COS | BOAK - |
| | 5.22' |
| 75.00 TAKK PING/ | I 10" JACK PINE/BT |
| 1 Stymp By AN | 6'STUMP DND SKN |
| al POST | |
| ND SIGN | |
| 5 UBLACK | |
| GONE & TRAIL | |
| 10 WHITE OAK | |
| GONE BT | |

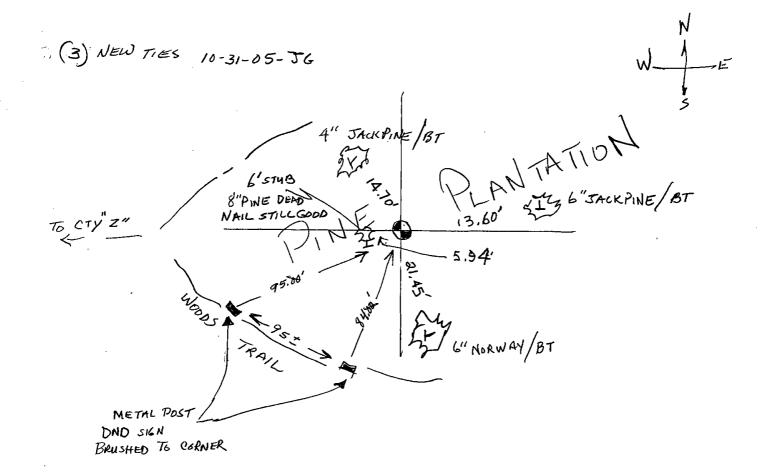

MAINTENANCE RECORD

| DATE | BY WHOM | REMARKS |
|----------|----------------------|-------------------------------------|
| 11-5-85 | SORENSEN | REMARKS ALL O.K. (3) NEW TIES OK |
| 10-31-05 | JG | (3) NEW TIES |
| 11-09-10 | SORENSEN JG SS | OK |
| | | |
| | | |
| | | |
| | | |
| | | · |
| | | |
| | | |
