

ADAMS COUNTY

Survey Monument Record

TYPE OF MONUMENT: Harrison

STATE PLANE COORDINATES: N _____

E _____

ELEVATION — M.S.L. DATUM: _____

THETA ANGLE: _____

FIELD BOOK: 54 PAGE 2

BASIS FOR MONUMENT LOCATION

(Use reverse side if necessary)


Show info such as: History of corner, with reference to Vol. and pg, dates, surveyor; exact description of monument replaced; if location computed, by taped or EDM traverse; landowner remarks, etc.

Excavated with backhoe. Found nothing.
Corner set from Hiawatha Trail Estates
Subdivision.


MON. BEEPS - TIES OK KV-SK 10/1/80
ALL OK 7-16-85 D.K.
1 NEW 3-23-90 KZ-SS
1 NEW - 16ONE 2-10-00 T.W.-SS.
OK 3-4-05 JS-SS

TIE SKETCH

(Show at least four ties)

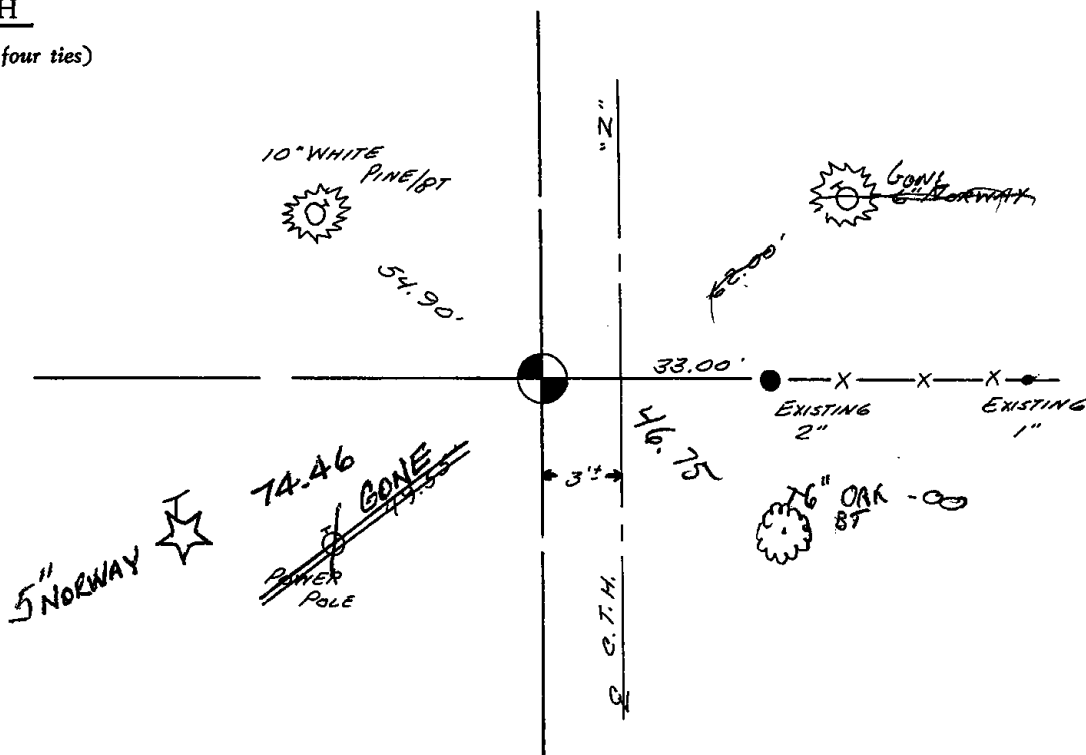

CORNER NO. 23
SECTION 8
TOWN 16
RANGE 5

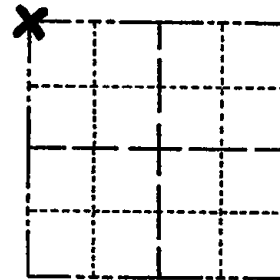

LOCATION
(Indicated by 'X')

SEAL:



CERTIFIED CORRECT:

Anthony B. Kiedrowski
Registered Land Surveyor

DATE: 7/5/77