


Government Land Corner Certificate

ADAMS County
 TYPE OF MONUMENT: Harrison Cast Iron
 STATE PLANE COORDINATES: N _____
 E _____
 ELEVATION — M.S.L. DATUM: _____
 THETA ANGLE: _____
 FIELD BOOK: Project Folder PAGE _____
 DRAWN BY: Marvin Seymour

CORNER NO. 26
 SECTION 4
 TOWN 16
 RANGE 5

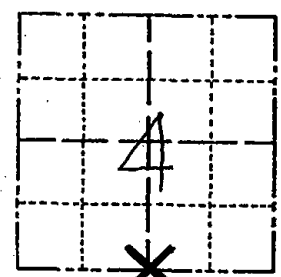

LOCATION
 (Indicated by 'X')

BASIS FOR MONUMENT LOCATION

Show info such as: History of corner, with reference to Vol. and pg., dates, surveyor; exact description of monument replaced; if location computed, by taped or EDM traverse; landowner remarks, etc. (Use reverse side if necessary)

Set at midpoint on line between SW & SE corners.

The distances to the lake shore match very good to the original calls.

If the distance from (Williams' 1871 map) C₄ 9 to this corner was used the corner would move north 10' and east 30'. It would not match original calls to the lake shore then.


ALL OK 6-21-85 DK

ALL OK 7-10-90 JG-SS

ALL OK 4-17-00 - JG

ALL OK 1-3-06 - JG

SEAL:

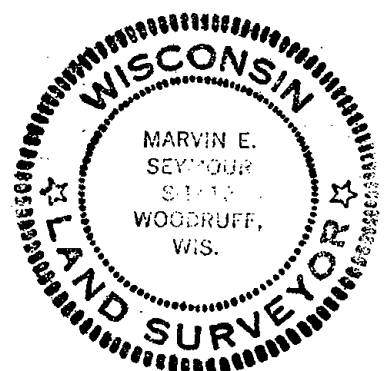

DATA SHOWN HERE ON
 CERTIFIED CORRECT:

Marvin E. Seymour
 Registered Land Surveyor

DATE: August 18, 1980

TIE SKETCH

Show at least four ties, also fence lines, roads, topo, size and type of witness trees and if off road - best way to arrive at corner.

