

ADAMS COUNTY

Survey Monument Record

TYPE OF MONUMENT: Standard Harrison

STATE PLANE COORDINATES: N _____
E _____

ELEVATION — M.S.L. DATUM: _____

THETA ANGLE: _____


FIELD BOOK: 37 PAGE 65

CORNER NO. 32 (32)

SECTION 12

TOWN 16

RANGE 5

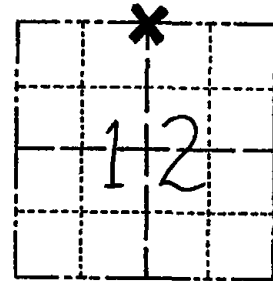

LOCATION
(Indicated by 'X')

SEAL:



BASIS FOR MONUMENT LOCATION

(Use reverse side if necessary)

Show info such as: History of corner, with reference to Vol. and pg. dates, surveyor; exact description of monument replaced; if location computed, by taped or EDM traverse; landowner remarks, etc.

Ran EDM/T2 traverse around Sections 8, 9, 10, 11 and 12 to determine search area.

Could find no evidence of the original corner, any remonumentation or any accessory monuments.

Re-established corner by single proportionate on line between adjacent section corners.

Set Harrison Monument on 10-11-76.

MON + TIES OK RN-SK 1/15/81
WALKED IN W/HIP CHAIN FROM 40 LINE EAST
NO EVIDENCE OF CORNER OR TIES—
APPEARS GRUBBED OUT FOR NEW MARSH
2-15-90 KZ-GR

NO EVIDENCE 3/10/95 JG-GR
OF CORNER

NO EVIDENCE, AREA UNDER ICE 12/20/05-SG

CERTIFIED CORRECT:


Dale C Hagen
Registered Land Surveyor
DATE: 11-30-76

TIE SKETCH

(Show at least four ties)

NOTE:

Ties in trees to
nail in disc.

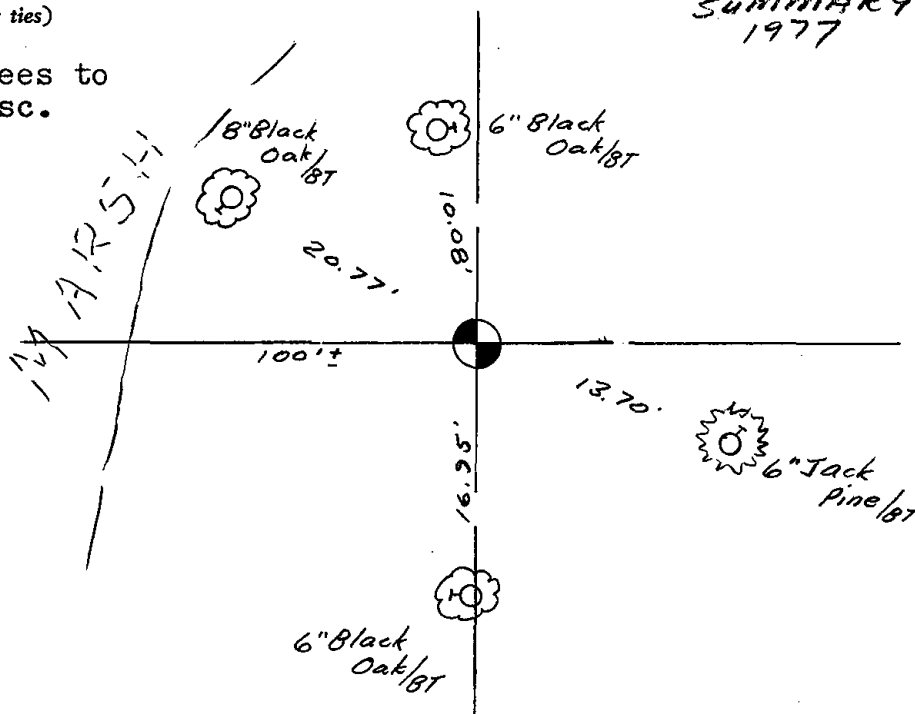

SEE D. HAGEN SECTION
SUMMARY - SECTION 12
1977 FILE