O5 RANGE ADAMS COUNTY C

PUBLIC LAND SURVEY MONUMENT RECORD

TYPE OF MONUMENT: 2-3/8" O.D. IRON PIPE WITH ALUMINUM CAP ADAMS COUNTY COORDINATES, NAD 83 (2007)

N. 188403.810

E. 515200.496


ELEVATION-DATUM

01/18/2021 FIELD WORK DATE:


BASIS FOR MONUMENT LOCATION

1981 - PLS 1444 THIS CORNER WAS SET EQUIDISTANT AND ON A STRAIGHT LINE BETWEEN SECTION CORNERS. NO EVIDENCE OF THE ORIGINAL CORNER OR ANY RESURVEY CORNER WAS FOUND.

2021 - PLS 2675 FOUND 2-3/8" O.D. IRON PIPE WITH ALUMINUM CAP FLUSH WITH THE MARSH SURFACE AND 2 TIES. THE MONUMENT AGREES WITH BOTH TIES. ACCEPTED THE 2-3/8" O.D. IRON PIPE WITH ALUMINUM CAP AS THE CORNER LOCATION. SET 4 NEW TIES AND MEASURED TO THE EXISTING TIES.

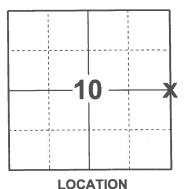


(INDICATE CORNER BY "X")

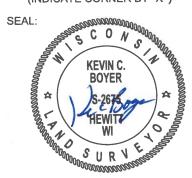

DATA SHOWN HERE ON THIS TIE SHEET IS CORRECT AND COMPLETE TO THE BEST OF MY KNOWLEDGE AND BELIEF.

PROFESSIONAL LAND SURVEYOR

DATE 2 23/2021

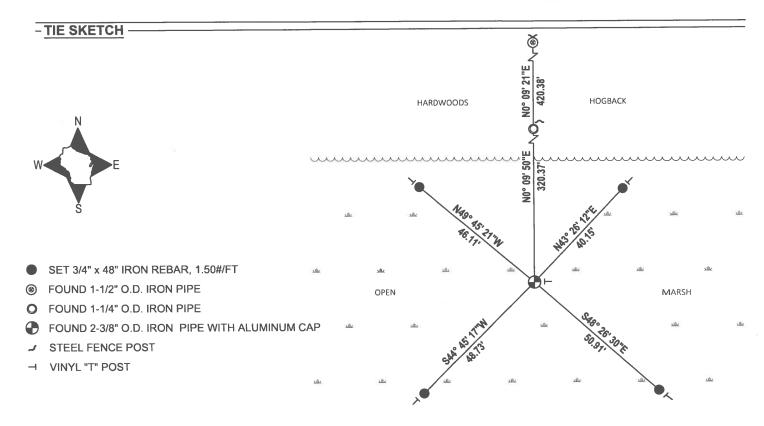

Government Land Corner Certificate	•	
ADAMS County	CORNER NO38	_
TYPE OF MONUMENT: 2"x 6' IRON PIPE/ALUM, CAP	SECTION /0	_
STATE PLANE COORDINATES: N	TOWN	
F	RANGE	_
ELEVATION — M.S.L. DATUM:	 	
THETA ANGLE:		
FIELD BOOK: 76 PAGE 47		
DRAWN BY:		
BASIS FOR MONUMENT LOCATION	, in the second	
Show info such as: History of corner, with reference to Vol. and pg., dates, surveyor; exact description of monument replaced; if location computed, by taped or EDM traverse;	LOCATION	
landowner remarks, etc. (Use reverse side if necessary)	(Indicated by 'X')	
Si .	EAL:	
	HINESCONO SILLING	
This corner was set equidistant and on a straight line	LANCE J. HABECK S-1444 Stayone Point	
between section corners. No evidence of the original	LANCE J.	
corner or any resurvey corner was found.	HABECK S.1444	
ALL OK 5-28-85 D.K.	Stevens Point, Wis,	
ALL OK 9-5-90 JG-SS		
1-10-06 JGSS RESET SOUTHERLY 11/4"FP	SI OVERS	
WITNESS PIPE FROM TIES, - PLACE	110000000000000000000000000000000000000	
STEEL POST @ BOTH IRON PIPES	OATA SHOWN HERE ON	
NEW TIES AS SHOWN	CERTIFIED CORRECT:	
12-07-10 OK GR-55	Janes J. Habed	
	egistered Land Surveyor	
BLAZE TO D	PATE: 1/6/8/	
THE CUETOII		
TIE SKETCH	8"THIN DND SIGN BLACKOAK/ FACING WEST	
Show at least four ties, also fence lines, roads, topo, size and type of witness trees' and if off road - best way to	BLAZE MARSH	
arrive at corner.	\	W
₩ 1	√	12
ON SECTION LINE ON SEC	\ \ \ \ \ \ \ \ \ \ \ \ \ \ \ \ \ \ \	
12.64 10 B	ON E	
V W	BLAZE Y	
	106 1	γ .
	2" BUK OF	4K
	DVO S	
10"WHITE MARSH W	NUMACKIESOUTHS TO	. `
	AND PROS	
AT 94.65	11 6" Jack purchus	\
CICULEAST "	14.20' 12 BEAZESIGN FACING THE	
FO STEEL TO	· NE	d.
V POST I'MEST	Viso OTOCK ONE VI	14
V v	MAZ BLAZE Y	\
y v	Fri \/v	/
, , , , , , , , , , , , , , , , , , ,	W Y W	

MAINTENANCE RECORD

DATE	BY WHOM	REMARKS
	\	
-		