SECTION

OS ADAMS COUNTY

COUNTY CORNER NO: 40

ROMPORTOL ID: 41605122000


PUBLIC LAND SURVEY MONUMENT RECORD

TYPE OF MONUMENT: HARRISON ADAMS COUNTY COORDINATES, NAD 83 (2007) N. **188468.332** E. 525839.753 DATUM_ _ _ ___ **ELEVATION-**FIELD WORK DATE: 11/13/2017

BASIS FOR MONUMENT LOCATION

1976 - PLS 1103 RAN EDM/T2 TRAVERSE AROUND SECTION 8, 9, 10, 11 AND 12 TO DETERMINE THE SEARCH AREA. FOUND A DOWN FENCE LINE THRU THE SEARCH AREA AND APPARENT BEARING TREE TO THE NORTHWEST. EXCAVATED AT THE INTERSECTION OF TIE DISTANCE TO BEARING TREE AND FENCE LINE. FOUND A ROUND STAIN IN EXCAVATION FROM ANCIENT POST, SET A HARRISON MONUMENT AT STAIN LOCATION AND RE-TIED.

2017 - PLS 2994 FOUND A HARRISON MONUMENT FLUSH WITH THE GROUND SURFACE AND 4 WITNESS TREES. THE MONUMENT AGREES WITH THE EXISTING WITNESS TREES. ACCEPTED THE HARRISON MONUMENT AS THE CORNER LOCATION. SET 4 NEW TIES AND MEASURED TO THE TIES AND WITNESS TREES.

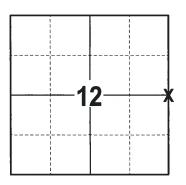

LOCATION (INDICATE CORNER BY "X")



DATA SHOWN HERE ON THIS TIE SHEET IS CORRECT AND COMPLETE TO THE BEST OF MY KNOWLEDGE AND BELIEF.


PROFESSIONAL LAND SURVEYOR

DATE

- TIE SKETCH



3/4" x 18" IRON REBAR SET, 1.50#/FT HARRISON FOUND STEEL FENCE POST VINYL "T" POST WITNESS TREE FOUND

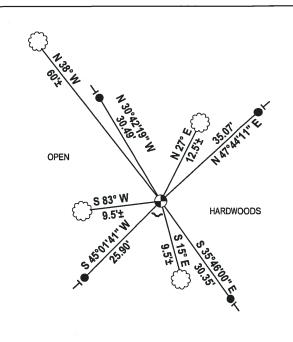

ADAMS COUNTY

Survey Monument Record

TYPE OF MONUMENT: Harrison Monument


STATE PLANE COORDINATES: N______

E
ELEVATION — M.S.L. DATUM: _____

THETA ANGLE: _____

FIELD BOOK: _____ 38 ____ PAGE ____18

CORNER NO.	
SECTION	12
TOWN	16
RANGE	5

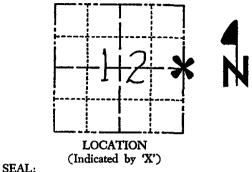

Wisconsin Rapids

BASIS FOR MONUMENT LOCATION

(Use reverse side if necessary)

Show info such as: History of corner, with reference to Vol. and pg, dates, surveyor; exact description of monument replaced; if location computed, by taped or EDM traverse; landowner remarks, etc.

Rah EDM/T2 traverse around Sections 8, 9, 10, 11 and 12 to determine search area.

Found down fenceline thru search area and apparent bearing tree to Northwest.

Excavated at intersection of tie distance to tree and fence line. Found round stain in excavation from ancient post.

Remonumented post stain with Harrison Monument on 10-15-76.

COR OK 10/6/80 KU-SK

7-22-85 SS - DK ALL OK 8-29-90 GR-JG 1-CONE, 1-NEW 3/10/95 JG-CR ALL OK, 5/9/00 - JG CERTIFIED CORRECT:

Registered Land Surveyor

DATE: 11-30-76

face of Rattlesnake Md.

1-GONE 1-NEW. 12/20/05-JG TIE SKETCH OK -1-4-11 NOTE: 16" Black (Show at least four ties) Oak let Ties in trees to ORIGINAL NOTES Nail in disc. 14" BLK OAK N65° W but stanoine 77 LINES = 50.82 FENCE DOWN FENCE DOWN DND SIGN ON METAL POST WEST OF CORNER NEW 5"Black DND SIEN FACING Note: corner is 250't west of