

## PUBLIC LAND SURVEY MONUMENT RECORD

TYPE OF MONUMENT: HARRISON (BROKEN-TOP)  
 ADAMS COUNTY COORDINATES, NAD 83 (2007)

N. 185842.061

E. 496624.625


ELEVATION- \_\_\_\_\_ DATUM \_\_\_\_\_

FIELD WORK DATE: 01/13/2021

### BASIS FOR MONUMENT LOCATION

1977 - PLS 878 EXCAVATED WITH BACKHOE. FOUND 6"X10"X6" HIGH SANDSTONE. LOWERED STONE AND SET HARRISON ON TOP. STONE CALLED FOR BY J.S. WILLIAMS PER LOOSE NOTES, MARCH 30, 1871.

2021 - PLS 2675 FOUND HARRISON (BROKEN-TOP) MONUMENT 10"± BELOW THE ROAD SURFACE AND DID NOT RECOVER ANY EXISTING TIES OR WITNESSES. ACCEPTED THE HARRISON (BROKEN-TOP) AS THE CORNER LOCATION. SET 4 NEW TIES AND MEASURED TO A FOUND RAILROAD SPIKE IN THE ROAD.

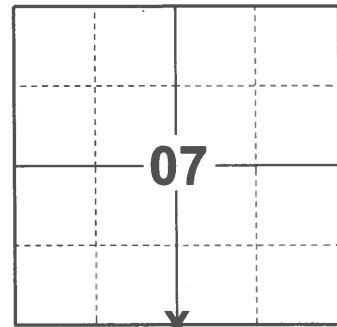

**LOCATION**

(INDICATE CORNER BY "X")

SEAL:





DATA SHOWN HERE ON THIS TIE SHEET IS CORRECT AND COMPLETE TO THE BEST OF MY KNOWLEDGE AND BELIEF.

PROFESSIONAL LAND SURVEYOR

DATE 2/23/2021

### TIE SKETCH

NOTE: THE CORNER LANDS 1'± NORTH OF CENTERLINE OF EDGEWOOD AVE.

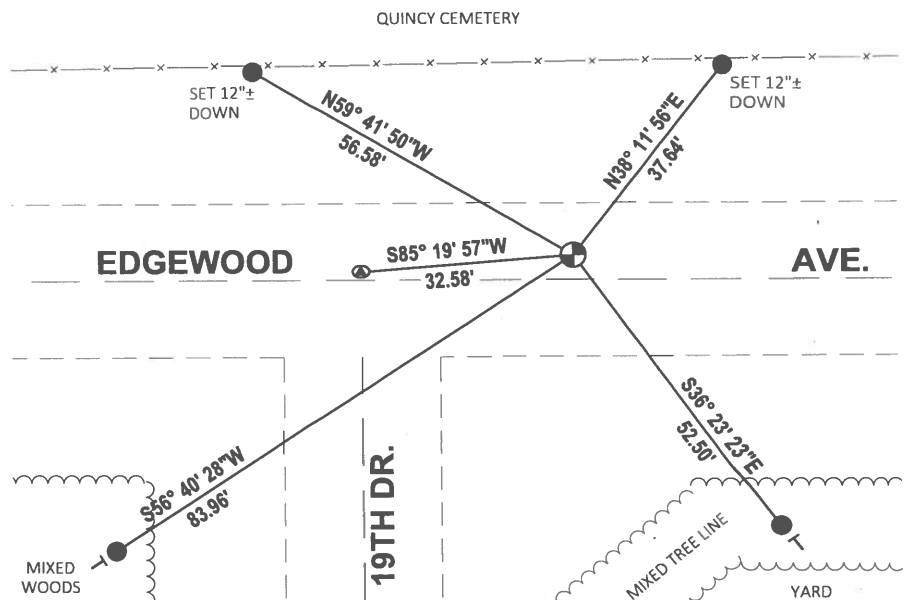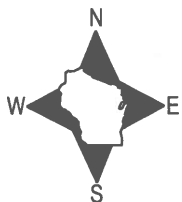

- SET 3/4" x 18" IRON REBAR, 1.50#/FT
- ⊕ FOUND RAILROAD SPIKE
- ⊕ FOUND HARRISON (BROKEN-TOP) MONUMENT
- ⊖ VINYL "T" POST

72

# Government Land Corner Certificate

ADAMS County

TYPE OF MONUMENT: Harrison

STATE PLANE COORDINATES: N \_\_\_\_\_  
E \_\_\_\_\_

ELEVATION — M.S.L. DATUM: \_\_\_\_\_

THETA ANGLE: \_\_\_\_\_

FIELD BOOK: 101 PAGE 59


DRAWN BY: 1

CORNER NO. \_\_\_\_\_

SECTION 7

TOWN 16

RANGE 5

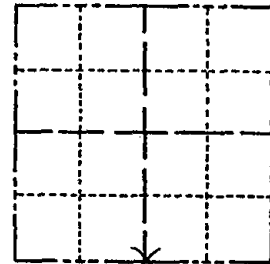

LOCATION  
(Indicated by 'X')

## BASIS FOR MONUMENT LOCATION

Show info such as: History of corner, with reference to Vol. and pg., dates, surveyor; exact description of monument replaced; if location computed, by taped or EDM traverse; landowner remarks, etc. (Use reverse side if necessary)

Excavated with backhoe. Found 6 x 10 x 6" high sandstone. Lowered stone and set Harrison on top. Stone called for by J.S. Williams per loose notes, March 30, 1871.

SEAL:


DATA SHOWN HERE ON  
CERTIFIED CORRECT:

Registered Land Surveyor

DATE: 4/11/77

## TIE SKETCH

Show at least four ties, also fence lines, roads, topo, size and type of witness trees and if off road - best way to arrive at corner.

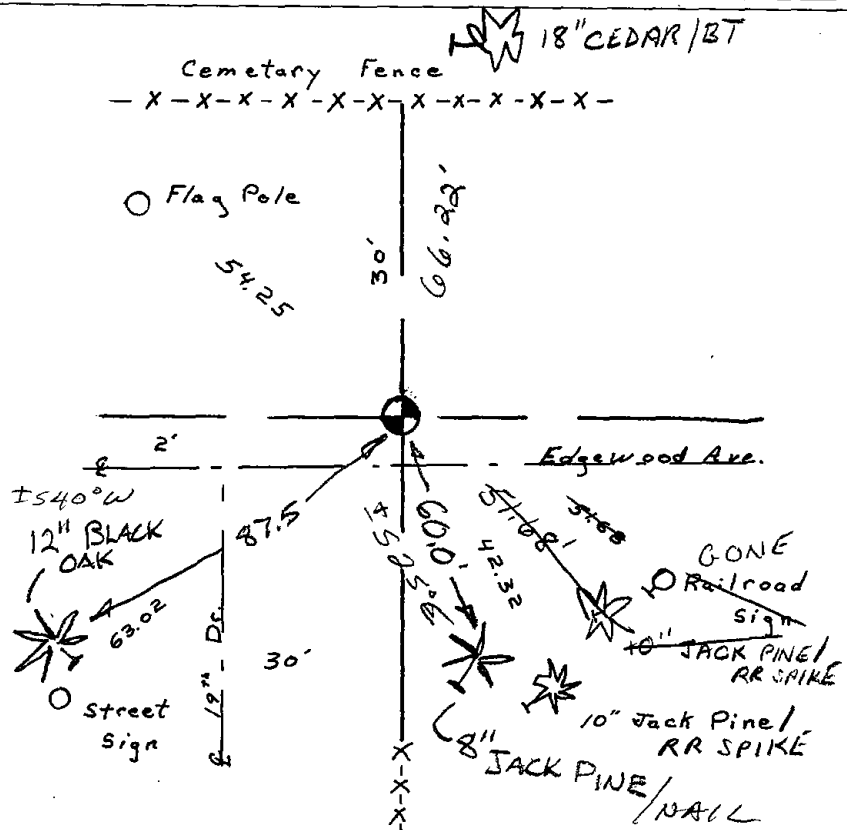

## MAINTENANCE RECORD

Date	Init.	Remarks
10/1/80	MV-SK	MON. BROKEN OFF 8"
4/15/85	DK.	ALL OK
2-8-90	KZ-SS	ALL OK
1-13-95	SS-BS	ALL OK
2-10-00	TL-SS	ALL OK
3-3-05	SS JB	2 NEW
10-26-10	SS	OK