05 RANGE ADAMS COUNTY C

PUBLIC LAND SURVEY MONUMENT RECORD

HARRISON (BROKEN-TOP) TYPE OF MONUMENT: ADAMS COUNTY COORDINATES, NAD 83 (2007)

N. 185896.933

E. 501912.632


ELEVATION-DATUM

FIELD WORK DATE: 01/13/2021


BASIS FOR MONUMENT LOCATION

1976 - PLS 878 EXCAVATED WITH BACKHOE. FOUND 6"X6"X12" PINK SANDSTONE IN FRACTURED CONDITION. REPLACED WITH HARRISON MONUMENT AND PILED STONES AROUND ITS BOTTOM. STONE CALLED FOR IN COUNTY SURVEYOR RECORDS, VOL. 1, PAGE 101.

2021 - PLS 2675 FOUND HARRISON (BROKEN-TOP) MONUMENT 12"± BELOW THE ROAD SURFACE AND DID NOT RECOVER ANY EXISTING TIES OR WITNESSES. ACCEPTED THE HARRISON (BROKEN-TOP) AS THE CORNER LOCATION. SET 3 NEW TIES AND MEASURED TO A FOUND PROPERTY IRON.

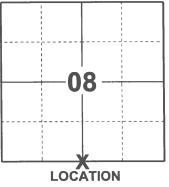

(INDICATE CORNER BY "X")

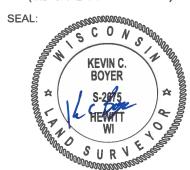

DATA SHOWN HERE ON THIS TIE SHEET IS CORRECT AND COMPLETE TO THE BEST OF MY KNOWLEDGE AND BELIEF.

PROFESSIONAL LAND SURVEYOR


DATE 2/23/2021

- TIE SKETCH

NOTE: THE CORNER LANDS 1.5'± SOUTH OF CENTERLINE OF EDGEWOOD AVE.



- SET 3/4" x 18" IRON REBAR, 1.50#/FT
- FOUND 3/4" IRON ROD
- FOUND HARRISON (BROKEN TOP) MONUMENT
- STEEL FENCE POST
- VINYL "T" POST

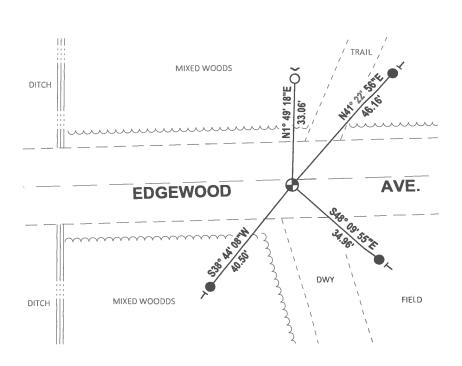

ADAMS COUNTY

Survey Monument Record	
TYPE OF MONUMENT: Harrison standard	_
TATE PLANE COORDINATES: N	_
F	

ELEVATION — M.S.L. DATUM: THETA ANGLE: .

file FIELD BOOK: _ PAGE -

SEAL:

CORNER NO. _

SECTION TOWN **RANGE**

BASIS FOR MONUMENT LOCATION

(Use reverse side if necessary)

Show info such as: History of corner, with reference to Vol. and pg, dates, surveyor; exact description of monument replaced; if location computed, by taped or EDM traverse; landowner remarks, etc.

Excavated with backhoe. Found 6x6x12" pink sandstone in fractured condition. Replaced with harrison monument and piled stones around its bottom.

Stone called for in County surveyor records, Vol. 1, Page 101.

KU-SK 10/1/80 CORNER OK ALL OK 4/15/85 D.K ALL OK 2-8-90 KZ 1-11-95 56-55

AZLOK 2-10-00 T.W. SS. ALLOK 10-31-05-JG 2 NEW 10-26-10 SS

CERTIFIED CORRECT: Registered Land Surveyor DATE: 8/26/76

TIE SKETCH

(Show at least four ties)

NOTE: Ties in trees to nail in disc.

