O5 RANGE ADAMS COUNTY C


PUBLIC LAND SURVEY MONUMENT RECORD

TYPE OF MONUMENT:	HARRISON (BROKEN-TOP)
ADAMS COUNTY COORDIN	ATES, NAD 83 (2007)
N185954.13	7
E. 507203.889	
ELEVATION — —	DATUM
FIELD WORK DATE: 01	/13/2021

BASIS FOR MONUMENT LOCATION

1977 - PLS 1103 RAN EDM/T2 TRAVERSE AROUND SECTIONS 8, 9, 10, 11, AND 12 TO DETERMINE SEARCH AREAS FOR INVESTIGATION. EXCAVATION WITH BACKHOE BY A.B. KIEDROWSKI, ADAMS COUNTY SURVEYOR, YIELDED NO EVIDENCE OF THE ORIGINAL CORNER OR ANY REMONUMENTATION. SET CORNER EQUIDISTANT BETWEEN ADJACENT SECTION CORNERS AT THE RECORD DISTANCE FROM THE CENTER OF SECTION 9 (WILLIAMS IN 1871) SET HARRISON MONUMENT 9-14-1976.

2021 - PLS 2675 FOUND HARRISON (BROKEN-TOP) MONUMENT 6"± BELOW THE GROUND AND DID NOT RECOVER ANY EXISTING TIES OR WITNESSES. ACCEPTED THE HARRISON (BROKEN-TOP) AS THE CORNER LOCATION AND SET 4 NEW TIES.

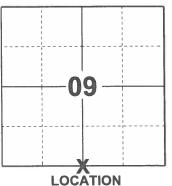

(INDICATE CORNER BY "X")



DATA SHOWN HERE ON THIS TIE SHEET IS CORRECT AND COMPLETE TO THE BEST OF MY KNOWLEDGE AND BELIEF.

PROFESSIONAL LAND SURVEYOR

- TIE SKETCH


NOTE: THE CORNER LANDS 23'± NORTH OF CENTERLINE OF EDGEWOOD AVE.



SET 3/4" x 18" IRON REBAR, 1,50#/FT

FOUND HARRISON (BROKEN-TOP) MONUMENT

VINYL "T" POST

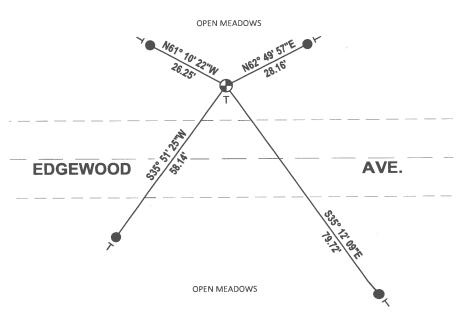

46 ADAMS COUNTY CORNER NO. _ SECTION / Survey Monument Record TOWN TYPE OF MONUMENT: HARRISON 5 RANGE STATE PLANE COORDINATES: N. ELEVATION — M.S.L. DATUM: _ THETA ANGLE: _ 38 FIELD BOOK: ___ _ PAGE _ BASIS FOR MONUMENT LOCATION (Use reverse side if necessary) LOCATION Show info such as: History of corner, with reference to Vol. and pg, dates, surveyor; exact description of monument replaced; if location computed, by taped or EDM traverse; landowner (Indicated by 'X') SEAL: Ran EDM/T2 traverse around Sections 8, 9, 10, 11 and 12 to determine search areas for investigation. DAILE C Excavation with backhoe by A.B. Kiedrowski, HHAYGHEINI Adams County Surveyor, yielded no evidence \$111038 of the original corner or any remonumentation. Wisconsin Rapids Wis. Set corner equidistant between adjanent section corners at the record distance from the center of Section 9 (Williams in 1871.) Set Harrison monument 9-14-76. CORNER OR KU-SK 10/1/80 Ties OK 4/15/85 2-GONE, 2-NEW 8-29-90 GR-JG Registered Land Surveyor ALL OK 1-11-95 JG-55 ALLOK + INEW 2-10-00 T.L. TIE SKETCH OK 7-7-10 4NDERWATER 8" ASPEN/DNO NOTE (Show at least four ties) Ties in trees to nail in disc. (N23°W) GONE 1990 (N 23°E) "POPLAR NOTE Bearings are NAIL IN local magnetic. SPLIT RAIL FENCE (BT) 口文 口 boz 152.44 GONE 3rd From east **FOGEWOOD** TOPCHARL - DO POWER POLE (542°W) 10'±

REVISED 1974

BLACK DAK

DND FACING NORTH