05 ADAMS COUNTY COUNTY COUNTY COUNTY CORNER NO: 49

ROMPORTOL ID: 41605100000

PUBLIC LAND SURVEY MONUMENT RECORD

HARRISON TYPE OF MONUMENT: ADAMS COUNTY COORDINATES, NAD 83 (2007) N. 185764.295

E. 515194.679


ELEVATION-DATUM

01/20/2021 FIELD WORK DATE:

BASIS FOR MONUMENT LOCATION

1976 - PLS 1103 RAN EDM/T2 TRAVERSE AROUND SECTION 14 TO DETERMINE SEARCH AREAS. FOUND STUB OF BEARING TREE SET BY A.J. BARRETT, ADAMS COUNTY SURVEYOR, ON MARCH 6-8, 1902 AS RECORDED ON VOLUME 1, PAGE 1 OF ADAMS COUNTY SURVEY RECORDS AND IN FIELD BOOK 3, PAGES 5-13. (12" BLACK OAK, N67°E, 73 LINKS) FROM BEARING TREE FOUND ORIGINAL POST STAIN, WITH POST LYING HORIZONTALLY JUST BELOW SURFACE. ALSO TRIANGULAR SANDSTONE (6"X10"X18") LYING ALONG POST. REMONUMENTED STAIN, WHICH FIT BEARING TREE. THERE ARE TWO BEARING TREES (SW AND SE) FACING CORNER FOR WHICH THERE IS NO RECORD ON FILE IN THE COUNTY SURVEYORS OFFICE.

2021 - PLS 2675 FOUND A HARRISON MONUMENT FLUSH WITH THE GROUND AND DID NOT RECOVER ANY EXISTING TIES OR WITNESSES DUE TO LOGGING IN THE AREA. ACCEPTED THE HARRISON AS THE CORNER LOCATION. SET 2 NEW TIES AND MEASURED TO 3 FOUND IRON RODS (ORIGINS UNKNOWN).

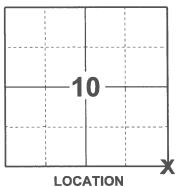

(INDICATE CORNER BY "X")



DATA SHOWN HERE ON THIS TIE SHEET IS CORRECT AND COMPLETE TO THE BEST OF MY KNOWLEDGE AND BELIEF.


PROFESSIONAL LAND SURVEYOR

DATE 2/23/2021

- TIE SKETCH



- SET 3/4" x 18" IRON REBAR, 1,50#/FT
- FOUND 3/4" IRON ROD
- FOUND HARRISON MONUMENT
- STEEL FENCE POST
- VINYL "T" POST

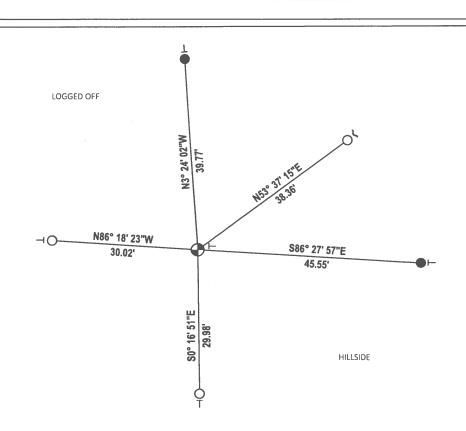

CORNER NO. ADAMS COUNTY SECTION Survey Monument Record TOWN TYPE OF MONUMENT: HARRISON RANGE STATE PLANE COORDINATES: N ELEVATION - M.S.L. DATUM: . THETA ANGLE: . FIELD BOOK: __ _ PAGE BASIS FOR MONUMENT LOCATION (Use reverse side if necessary) Show info such as: History of corner, with reference to Vol. and pg, dates, surveyor; exact description of monument replaced; if location computed, by taped or EDM traverse; landowner SEAL: Ran EDM/T2 traverse around Section 14 to determine search areas. Found stub of bearing tree set by A.J. Barrett, Adams County Surveyor, on March 6-8, 1902 as recorded on Volume 1, Page 1 of Adams County Survey Records and in Field Book 3, Pages 5-13. (12" Black Oak, N 67° E, 73 Links) From bearing tree found original post stain, with post lying horizontally just below surface. Also triangular sandstone (6" x 10" x 18") lying along post. Remonumented stain, which fit bearing tree. There are two bearing trees (SW and SE) facing CERTIFIED CORRECT corner for which there is no record on file in the County Surveyors office. Registered Land Surveyor OK-7-23-85 DK-55 //-30-76 DATE: ALL OK 8-29-90 GR-JG NOTE TIE SKETCH 6" Black Oak Ties in trees to BT. (Show at least four ties) nail in disc. Black Oak (Stub) 10" Black Oak POWN OR GK 10/3/80 KU-SK FENCE THROUGH SWAMP 300'± GROUND 34 (Dead + Hollow) Jack

Black Oak

4" DIA NORWAY

APPEARS TO BE IT I

MOST SOUTHERLY

OF OTHER NORWAYS

IN AREA - I 30'

SOUTH OF 15' DAK

STUB 12' TALL

WITH OLD

BLAZE ON SOUTH MIR

NY

8" DIA - OAK STUB 4' TALL

18.70E

NAIL IN TOP TAPE
CENTER OF 20" DIA,
OAK STUMP-SAWED
OFF FLAT

65.20 W

ZO'DIA OAK.

RIS' TALL

TALL

1-10-06 JG-SS

AREA DECIMATED BY

TORNADO - BEST AVAILABLE TIES

SET 3" DIA. OAK POST | SIGN

ALL TIES HAVE SIGNS

12-07-10 GR OK