05 RANGE ADAMS COUNTY C

PUBLIC LAND SURVEY MONUMENT RECORD

1-1/4" O.D. IRON PIPE TYPE OF MONUMENT:

ADAMS COUNTY COORDINATES, NAD 83 (2007)

N. 185871.964

E. 523192.686


ELEVATION-DATUM__ - -

01/19/2021 FIELD WORK DATE:


BASIS FOR MONUMENT LOCATION

1976 - PLS 1103 RAN EDM/T2 TRAVERSE AROUND SECTIONS 8, 9, 10, 11, AND 12 TO DETERMINE SEARCH AREAS. INVESTIGATION YIELDED NO EVIDENCE OF THE ORIGINAL CORNER OR ANY REMONUMENTATION, OR ACCESSORY MONUMENTS. SET CORNER BY SINGLE PROPORTIONATE MEASURE BETWEEN ADJACENT SECTION CORNERS. SET 10-15-1976.

2021 - PLS 2675 FOUND A 1-1/4" O.D. IRON PIPE FLUSH WITH THE MARSH SURFACE AND DID NOT FIND ANY EXISTING TIES OR WITNESSES. (WAS VERIFIED TO BE ON A NEAR STRAIGHT LINE AND EQUIDISTANT SPLIT BETWEEN THE SOUTHWEST AND SOUTHEAST OF SECTION 12) ACCEPTED THE 1-1/4" O.D. IRON PIPE AS THE CORNER LOCATION. SET 4 NEW TIES.

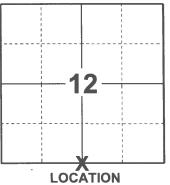

(INDICATE CORNER BY "X")

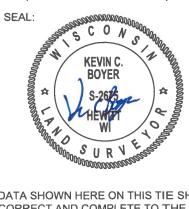

DATA SHOWN HERE ON THIS TIE SHEET IS CORRECT AND COMPLETE TO THE BEST OF MY KNOWLEDGE AND BELIEF.


PROFESSIONAL LAND SURVEYOR

DATE 2 23/2021

-TIE SKETCH



- SET 3/4" x 18" IRON REBAR, 1.50#/FT
- FOUND 1-1/4" O.D. IRON PIPE
- STEEL FENCE POST
- → VINYL "T" POST

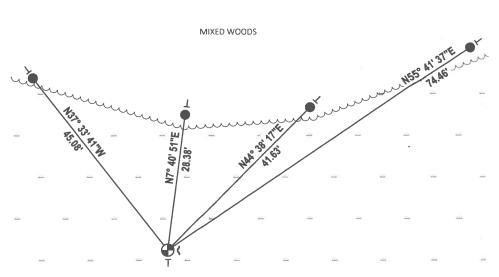

01-04-11	FOUND NO		(52)
ADAMS COUNTY EUIDENCE.	- SEE SECTIO		52 12
Survey Monument Record Applicant	FILES FOR L INFORMAT	SECTION _	
TYPE OF MONUMENT: Standard Harrison		TOWN _	16
STATE PLANE COORDINATES: N		RANGE _	5
ELEVATION — M.S.L. DATUM:			7
THETA ANGLE:	ļ ļo:		
FIELD BOOK: PAGE 18	į	1 2	
	ļ [—]		
BASIS FOR MONUMENT LOCATION			-
(Use reverse side if necessary)	L	-	」
Show info such as: History of corner, with reference to Vol. and pg, dates, surveyor; exact description of monument replaced; if location computed, by taped or EDM traverse; landowner remarks, etc.	SEAL:	LOCATION (Indicated by 'X')	
Ran EDM/T2 traverse around Sections 8, 10, 11, and 12 to determine search areas	9 , •	WISCONS!	100
Investigation yielded no evidence of the original corner or any remonumentation, accessory monuments.	e or ure	DALE C. HAGEN	
Set corner by single proportionate measurement adjacent section corners.	are	S-1103 Wisconsin Rapids, Wis.	
Set 10-15-76.		V.	A Sec.
MON & TIES OK RN-SK 1/13/8/	•	SURVA	383
Mon. OK, - 3 NEW TIES 11-7-85 GR-55		4105584687	
ALL OK 9-7-90 SS			
2-GONE, 2-NEW 3/16/95 JG-CR	CERTIFIEI	CORRECT,	3
FOUND HARNSON MONI LAYING ABOUT GROWND BE I" PIPE OF UNKNOWN ORGIN WAS PRESENT NEED	OKON Registered 1	Land Surveyor	en _
CHECK RECENT SURVEYS AND TALK TO LANDOW	NER 12-21-05- 7	11-30-76	
TIE SKETCH 9'JACK PINE	SH 6" JACK PINE		90'
(Show at least formation)	"DEAD" NOTE		
(Show at least four ties) GONE 95 GREAT	n-41	lies in trees ail in disc	s to
BT Z	"> ' ∕ ⁄⁄⁄⁄⁄⁄′ (" 2)\M	lagnetic bear	rings 🚄
(0)	s da a)	Quincy fire WES!	
02 g	134 (5)) Oak/a	N
A STEP IN	1 75 Bat	"95"	#17
J. S. W.	b)	South face of	
	<u> </u>	Lone Rock I	N 70° W
X	26)		
DAMMED UP	1. 12.	\	
WATER ESSE	120,	11-7-85 - ALL	
6" Black 7" P. 1. 1.	·/	ARE DEAD - NOW TACK A	PINE TIES
GAK/BT SET	ST/SURVEY SIGN		
,			

