O5 RANGE ADAMS COUNTY COUNTY CORNER NO: 58 ROMPORTOL ID: 41605152000

PUBLIC LAND SURVEY MONUMENT RECORD

HARRISON TYPE OF MONUMENT: ADAMS COUNTY COORDINATES, NAD 83 (2007) N. 183190.544


E. 515206.420 **ELEVATION-**DATUM

01/20/2021 FIELD WORK DATE:

BASIS FOR MONUMENT LOCATION

1977 - PLS 1103 RAN EDM/T2 TRAVERSE AROUND SECTION 14 AND PARTS OF ADJOINING SECTIONS TO DETERMINE SEARCH AREAS FOR INVESTIGATION. COULD FIND NO EVIDENCE OF THE ORIGINAL CORNER OR ANY REMONUMENTATION. COULD FIND NO BEARING TREES, THOUGH AREA LOOKS VERY PROMISING. SET CORNER BY SINGLE PROPORTIONATE MEASURE ON LINE BETWEEN ADJACENT SECTION CORNERS. SET HARRISON MONUMENT ON 12-14-1976.

2021 -PLS 2675 FOUND HARRISON MONUMENT FLUSH WITH GROUND SURFACE AND DID NOT RECOVER ANY TIES OR WITNESSES. ACCEPTED THE HARRISON AS THE CORNER LOCATION. SET 4 NEW TIES.

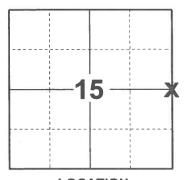

LOCATION (INDICATE CORNER BY "X")



DATA SHOWN HERE ON THIS TIE SHEET IS CORRECT AND COMPLETE TO THE BEST OF MY KNOWLEDGE AND BELIEF.

PROFESSIONAL LAND SURVEYOR

-TIE SKETCH




MIXED WOODS HILLSIDE

SET 3/4" x 18" IRON REBAR, 1.50#/FT

FOUND HARRISON MONUMENT

VINYL "T" POST

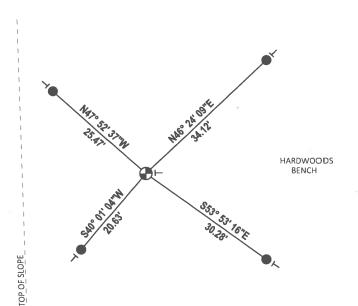

CORNER NO. 58 ADAMS COUNTY SECTION Survey Monument Record TOWN TYPE OF MONUMENT: HARRISON STATE PLANE COORDINATES: N RANGE ELEVATION — M.S.L. DATUM: THETA ANGLE: . PAGE _ 23 DALE C. HAGEN S-1103 Wisconsin Rapids Wis. BASIS FOR MONUMENT LOCATION (Use reverse side if necessary) Show info such as: History of corner, with reference to Vol. and pg, dates, surveyor; exact description of monument replaced; if location computed, by taped or EDM traverse; landowner SEAL: remarks, etc. Ran EDM/T2 traverse around Section 14 and parts of adjoining sections to determine search areas for investigation. Could find no evidence of the original corner or any remonumentation. Could fing no bearing trees, though area looks very promising. Set corner by single proportionate measure on line between adjacent section corners. Set Harrison monument on 12-14-76. COR. OK 10/3/80 KU-SK ANOK 5/28/85 ALL OK 8-29-90 GR-JG SS - SIGNS ON 1-10-06 Registered Land Surveyor 1/1 12-8-10 GR DATE7-5-7 TIE SKETCH NOTE (Show at least four ties) Ties in trees to nail in disc.

