TOWN

# ADAMS COUNTY COUNTY COUNTY CORNER NO: 63 ROMPORTOL ID: 41605180000

# PUBLIC LAND SURVEY MONUMENT RECORD

HARRISON (BROKEN-TOP) TYPE OF MONUMENT: ADAMS COUNTY COORDINATES, NAD 83 (2007) N. 180535.801

E. 499320.750

DATUM **ELEVATION-**

FIELD WORK DATE: 02/02/2021

#### **BASIS FOR MONUMENT LOCATION**


1972 - PLS 981 FOUND "PK" NAIL, SET 30" HARRISON MONUMENT (ALSO FOUND A RAILROAD SPIKE).

2005 - PLS 2168 FOUND STANDARD HARRISON 18" DEEP WITH THE TOP BROKEN OFF. AS PER DISCUSSION WITH THE ADAMS COUNTY SURVEYOR, SET TIES WELL OUT INTO SAFE AREAS AND RETURNED TO PLACE MAG NAIL IN ROAD SURFACE OVER MONUMENT AFTER PAVING COMPLETE.

2021 - PLS 2675 FOUND SURVEY NAIL IN THE ROAD SURFACE, REMOVED, AND FOUND HARRISON (BROKEN-TOP) MONUMENT 18"± DOWN AND 4 EXISTING TIES. THE MONUMENT AGREES WITH ALL 4 TIES. ACCEPTED THE HARRISON (BROKEN-TOP) AS THE CORNER LOCATION AND MEASURED TO THE EXISTING TIES.



(INDICATE CORNER BY "X")

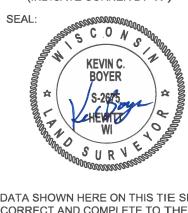

DATA SHOWN HERE ON THIS TIE SHEET IS CORRECT AND COMPLETE TO THE BEST OF MY KNOWLEDGE AND BELIEF.

PROFESSIONAL LAND SURVEYOR


1202

#### - TIE SKETCH

NOTE: THE CORNER LANDS 1'± NORTH OF CENTERLINE OF ELK AVE. AND 2'± EAST OF CENTERLINE OF CTH "Z".



- O FOUND 3/4" IRON ROD
- FOUND HARRISON (BROKEN-TOP) MONUMENT
- STEEL FENCE POST
- VINYL "T" POST

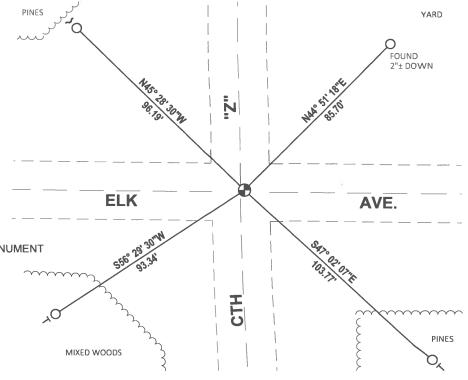

ADAMS COUNTY		CORNER NO	122
Survey Monument Record		SECTION	
TYPE OF MONUMENT: 30 " Harrison		TOWN .	16
STATE PLANE COORDINATES: N		RANGE	5
E	_		<del>-,</del> ,
ELEVATION — M.S.L. DATUM:	!		
THETA ANGLE:	ļ-		
11101	ļ		$\dashv$
DACIO FOR MONITAGENT Y CONTINUE			
BASIS FOR MONUMENT LOCATION			Ĺ
(Use reverse side if necessary) Show info such as: History of corner, with reference to Vol.	<u> </u>	LOCATION	<del>-X</del>
and pg, dates, surveyor; exact description of monument replaced; if location computed, by taped or EDM traverse; landowner remarks, etc.	SEAL:	(Indicated by 'X')	
Found"P. K. " nail, set 30 inch Harrison Mon May 10, 1972 R.L.S. 981— Sam T. Mullen  CORNER OK, 10/28/25 D.MS.S.	ument ( also four	nd R.R. spike	)
SELE DATED			
00,440,600,400,400	CERTIFIED	CORRECT:	
ALL OK 4/15/85 D.K  ALL OK 3-23-90 KZ-SS  1-GONE 2-7-95 JG 160NE 2NEW 2.	Registered L 10-00 T.V. S.,	and Surveyor	
TIE SKETCH Z NEW 3-4-05 TS-55 (SEE AT	TACHED SHEET O	10-17-0	s )
(Show at least four ties)	12-20-10		
(Circulate four acce)	سو .		
NAID TEHINAGE	GONE IN		
IN POWER POLE	TELE PROME POLE		
GROUND)		100.1	
So State	W 10" CEDAR	1870	
56.17	•		
_ e	ELK_AVEN		
127	85.25 EX		
S"ECTALAT JO.53 BOOM SOLE SOLE SOLE SOLE SOLE SOLE SOLE SOLE	ELEG B. W.E.Co.		
55,3 STREET MOULED	RESAURE IN		
N N	GONE 95'		
Sw Corpor orec &	*		
REVISED 1972			

# **ADAMS COUNTY** SURVEY MONUMENT RECORD

CORNER NO. SECTION 19 **TOWN 16 N.** RANGE 5 E.

LOCATION

minimus.

SCONS

PATRICK J.

TYPE OF MONUMENT: MAG NAIL OVER STANDARD HARRISON

ADAMS COUNTY COORDINATES NORTHING: **EASTING:** 

= CORNER MONUMENT RESTORED


BASIS FOR MONUMENT LOCATION (USE REVERSE SIDE IF NECESSARY)

SHOW INFO SUCH AS: HISTORY OF CORNER, WITH REFERENCE TO VOLUME AND PAGE DATES, SURVEYOR; EXACT DESCRIPTION OF MONUMENT PLACED OR FOUND, IF LOCATION COMPUTED, BY TAPED OR EDM TRAVERSE; LANDOWNER REMARKS, ETC.

FOUND STANDARD HARRISON 18" DEEP WITH THE TOP BROKEN OFF. AS PER DISCUSSION WITH THE ADAMS COUNTY SURVEYOR, SET TIES WELL OUT INTO SAFE AREAS AND RETURNED TO PLACE MAG NAIL IN ROAD SURFACE OVER MONUMENT AFTER PAVING COMPLETE.

### LEGEND

- = MAG NAIL IN ROAD SURFACE OVER STANDARD HARRISON WITH THE TOP BROKEN OFF
- = 3/4" X 24" IRON ROD SET
- > = 2" CHANNEL POST WITH GOV'T SIGN.

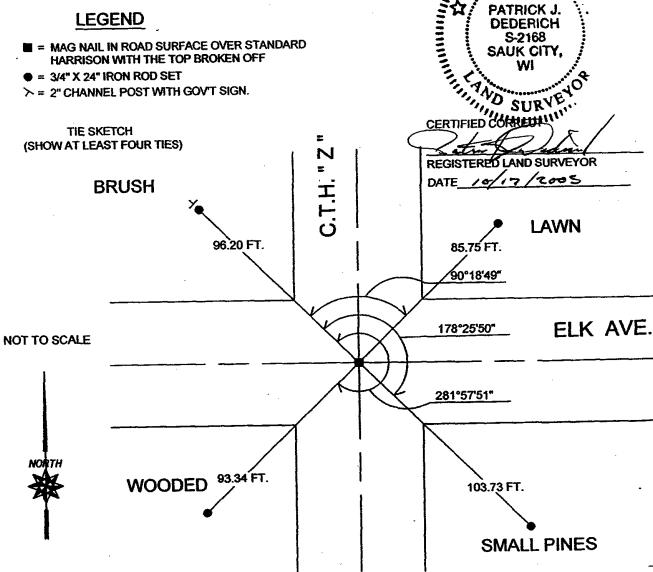

 $\mathcal{L}_{\mathcal{L}}$ 

TYPE OF MONUMENT: MAG NAIL OVER STANDARD HARRISON

ADAMS COUNTY COORDINATES **NORTHING: EASTING:** 

Г

**■** = CORNER MONUMENT RESTORED

BASIS FOR MONUMENT LOCATION (USE REVERSE SIDE IF NECESSARY)

SHOW INFO SUCH AS: HISTORY OF CORNER, WITH REFERENCE TO VOLUME AND PAGE DATES, SURVEYOR; EXACT DESCRIPTION OF MONUMENT PLACED OR FOUND, IF LOCATION COMPUTED, BY TAPED OR EDM TRAVERSE; LANDOWNER REMARKS, ETC.

FOUND STANDARD HARRISON 18" DEEP WITH THE TOP BROKEN OFF.

AS PER DISCUSSION WITH THE ADAMS COUNTY SURVEYOR, SET TIES WELL OUT INTO SAFE AREAS AND RETURNED TO PLACE MAG NAIL IN ROAD SURFACE OVER MONUMENT AFTER PAVING COMPLETE.

## **LEGEND**

- = MAG NAIL IN ROAD SURFACE OVER STANDARD HARRISON WITH THE TOP BROKEN OFF
- = 3/4" X 24" IRON ROD SET
- > = 2" CHANNEL POST WITH GOV'T SIGN.





**SMALL PINES** 

