O5 RANGE ADAMS COUNTY C

PUBLIC LAND SURVEY MONUMENT RECORD

HARRISON TYPE OF MONUMENT: ADAMS COUNTY COORDINATES, NAD 83 (2007) N. 180587.073 E. 501955.792 ELEVATION-DATUM - ---02/01/2021 FIELD WORK DATE:___

BASIS FOR MONUMENT LOCATION

1979 - PLS 878 NO RECORD OF RESURVEYS. EXCAVATED WITH BACKHOE, FOUND NOTHING. CORNER SET ON LINE AND EQUIDISTANT BETWEEN SECTION CORNERS.

2021 - PLS 2675 FOUND HARRISON MONUMENT 4"± BELOW THE ROAD SHOULDER AND DID NOT RECOVER ANY EXISTING TIES OR WITNESSES. ACCEPTED THE HARRISON AS THE CORNER LOCATION. SET 4 NEW TIES.



(INDICATE CORNER BY "X")




DATA SHOWN HERE ON THIS TIE SHEET IS CORRECT AND COMPLETE TO THE BEST OF MY KNOWLEDGE AND BELIEF.

PROFESSIONAL LAND SURVEYOR

-TIE SKETCH



- SET 3/4" x 18" IRON REBAR, 1.50#/FT
- FOUND HARRISON MONUMENT
- → VINYL "T" POST

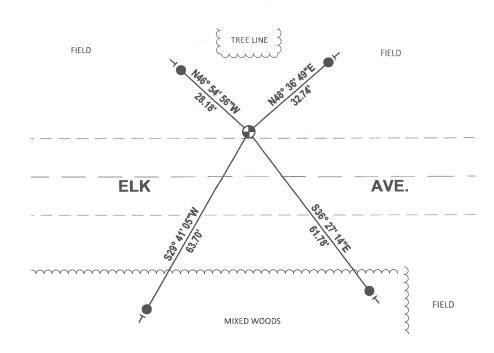

Government Land Corner Certificate		64
ADAMSCounty	CORNER NO.	20
TYPE OF MONUMENT: STANDARD HARRISON	SECTION	20
STATE PLANE COORDINATES: N	TOWN	16N
E	RANGE	5E
ELEVATION — M.S.L. DATUM:	—— ———————————————————————————————————	,
FIELD BOOK: 77 PAGE 4		
DRAWN BY: PAUL KIEDROWSKI		
DACIC FOR MONITIMENT LOCATION	=	או
BASIS FOR MONUMENT LOCATION		i
Show info such as: History of corner, with reference to Vol. and pg., dates, surveyor; exact description of monument replaced; if location computed, by taped or EDM traverse; landowner remarks, etc. (Use reverse side if necessary)	LOCATION (Indicated by 'X')	J
	SEAL:	'1 10.
No record of resurveys. Excavated with backhoe, found nothing. Corner set on line and equidistant between section corners.	ANTHONY KIEDROWS S-878 Wisconsin Ra	SININ
ALL OK 4/15/85	ANTHONY	В.
I GONE. NOTHING AVAILABLE FOR NEW TIE	KIEDROWS な S-878	SKI 🔭
2-8-90 Kz-SS	Wisconsin Ra	pids.
ALL OK 2-7-95 JG	Wis.	0.5
ALL OK 2-10-00 TW, S.S. " " 3-3-05 TS-55	SUB	Engl
11 11 7-7-10 55	Milliand	10,000
	DATA SHOWN HERE ON	
	CERTIFIED CORRECT:	. 0
	6/13/79 ABKO Registered Land Surveyor	chousti
	DATE:	
TIE SKETCH 1		
Show at least four ties, also fence lines, roads, topo, size and type of witness trees' and if off road - best way to arrive at corner.	N	
	' / [`	
* TWIN 8"	11	•
BLACK OF	AR	
13" WHITE OAK		
12 12 12 12 12 12 12 12 12 12 12 12 12 1	*	
143.24°		
		_
, No.	- 	
ELK PAVE		
ابر جود،	B 12"	
22"	BLACK OAK	
WHITE DAK	BT	
87 *		
*		
*		

MAINTENANCE RECORD

DATE	BY WHOM	REMARKS
10/2/80	KU-SK	CORNER OK
10/2/80 2-8-90	KZ-55	I GONE, NOTHING AVAIL FOR NEW TIE
	 	