17 SECTION

05 ADAMS COUNTY COUNTY

PUBLIC LAND SURVEY MONUMENT RECORD

HARRISON TYPE OF MONUMENT: ADAMS COUNTY COORDINATES, NAD 83 (2007) N. 180638.074 E. 504590.811 **ELEVATION-**DATUM

02/01/2021 FIELD WORK DATE:

BASIS FOR MONUMENT LOCATION

1979 -PLS 878 EXCAVATED WITH BACKHOE. FOUND BOTTOM 6" OF 4"X5" SANDSTONE AND SEVERAL FRAGMENTS OVER STAIN FROM POST. NO RESURVEYS IN AREA. REPLACED STONE WITH HARRISON AND PUT STONE ALONG WEST SIDE.

2021 - PLS 2675 FOUND HARRISON MONUMENT 6"± BELOW THE GROUND AND DID NOT RECOVER ANY EXISTING TIES OR WITNESSES. ACCEPTED THE HARRISON AS THE CORNER LOCATION, SET 4 NEW TIES.



(INDICATE CORNER BY "X")



DATA SHOWN HERE ON THIS TIE SHEET IS CORRECT AND COMPLETE TO THE BEST OF MY KNOWLEDGE AND BELIEF.


PROFESSIONAL LAND SURVEYOR

1505

-TIE SKETCH



- SET 3/4" x 18" IRON REBAR, 1.50#/FT
- FOUND HARRISON MONUMENT
- VINYL "T" POST

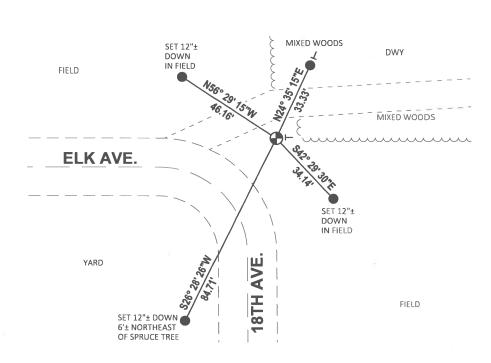

Government Land Corner Certificate		<i>~</i> ~
ADAMS County	CORNER NO	65_
TYPE OF MONUMENT: HARRISON	SECTION	20
STATE PLANE COORDINATES: N	TOWN .	16
E	RANGE _	<u>5</u>
ELEVATION — M.S.L. DATUM:		*
THETA ANGLE:		
DRAWN BY: B. SULLIVAN		i J .
		⊢ N
BASIS FOR MONUMENT LOCATION		
Show info such as: History of corner, with reference to Vol.		
and pg., dates, surveyor; exact description of monument replaced; if location computed, by taped or EDM traverse; landowner remarks, etc. (Use reverse side if necessary)	LOCATION	
landowner remarks, etc. (Use reverse side if necessary)	SEAL: (Indicated by 'X')	•••
Excavated with backhoe. Found bottom 6" of 4 x 5 san	detono minimi	NON
and several fragments over stain from post. No	ds tone	No.
resurveys in area. Replaced stone with harrison and	ANTHO	DNY B.
out stone along west side.	KIEDRO	
Location verified by EDM traverse	Wisconsi. Wi	n Rapids,
ALL OK 4/15/85 DK. ALL OK 2-8-90 KZ-55	- T	" Joseph
ALL OK 2-8-90 KZ-55 ALL OK 2-7-95 JG	SU	2 V 6 3 3 5 4
2 600 20x 2-10-00 TW. S.S.	4////	100000BB
" 3-3-05 JS-SS	DATA SHOWN HERE ON	
•	CERTIFIED CORRECT:	
		عطسورء
	Registered Land Surveyor DATE: 5/7/79	
	DATE: 5/1/13	
TIE SKETCH	Ž,	
Show at least four ties, also fence lines, roads, topo, size	Ţ '	
and type of witness trees' and if off road - best way to arrive at corner.	Ì	
16 BAKETUAR	Ţ	
O OAR STOMP	P 12" BURR	
	COAK BT	
	M Jack JOP CRIV	E
´c	SR BIACK TOP LA	
	m g't	
ELK AVE. d	38.21 F	~~~×
		<i>J</i> ,
		6"CEDAR
·		B,T_i
	TURN TURN	
	TA STOP	•
	AVE	
	m .	
	•	

MAINTENANCE RECORD

DATE	BY WHOM	REMARKS
10/2/80	KU-JK	CORNER OK
2-8-90	KZ-55	CORNER OK ALL OK
07-07-10	5.5	OK
		·
		<u> </u>