O5 RANGE ADAMS COUNTY C

PUBLIC LAND SURVEY MONUMENT RECORD

HARRISON TYPE OF MONUMENT: ADAMS COUNTY COORDINATES, NAD 83 (2007)

N. 180621.822

E. 509918.431

ELEVATION-

DATUM______

01/25/2021 FIELD WORK DATE:_


BASIS FOR MONUMENT LOCATION

1979 - PLS 1478 SET CORNER ON THE CENTERLINE OPPOSITE FENCE LINE TO THE NORTH. THIS LOCATION IS VERY NEARLY PROPORTIONATE IN THE EAST WEST DIRECTION AND IS ON A LINE EXTENDED OF A FENCE HEADING EAST FROM THE NORTHWEST CORNER OF SECTION 21. THIS CORNER ALSO FALLS VERY CLOSE TO ORIGINAL RECORD DISTANCES FROM THE SOUTH.

2021 - PLS 2675 FOUND HARRISON MONUMENT 16"± BELOW THE ROAD SURFACE AND 2 WITNESS TREES. THE MONUMENT AGREES WITH BOTH WITNESS TREES. ACCEPTED THE HARRISON AS THE CORNER LOCATION. SET 4 NEW TIES AND MEASURED TO THE EXISTING WITNESS TREES.



(INDICATE CORNER BY "X")

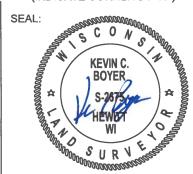

DATA SHOWN HERE ON THIS TIE SHEET IS CORRECT AND COMPLETE TO THE BEST OF MY KNOWLEDGE AND BELIEF.

PROFESSIONAL LAND SURVEYOR

-TIE SKETCH




SET 3/4" x 18" IRON REBAR, 1.50#/FT

FOUND HARRISON MONUMENT

VINYL "T" POST

WITNESS TREE

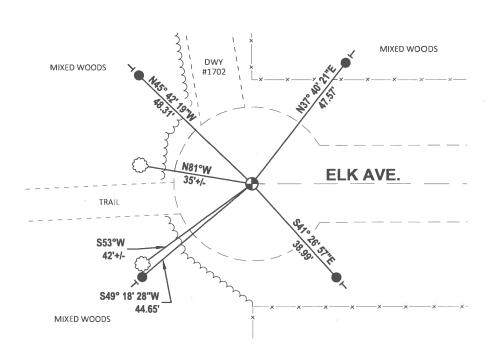

			•	
				:
				•

Government Land Corner Certificate

ADAMS	Cou	nty	
TYPE OF MONUMENT: HAR	RISON		
STATE PLANE COORDINATES:	N	<u></u>	
	<u>E</u>		
ELEVATION — M.S.L. DATUM:			
THETA ANGLE:			_
FIELD BOOK: 54	PAGE .	63	
DRAWN BY: R. NUBER			

BASIS FOR MONUMENT LOCATION

Show info such as: History of corner, with reference to Vol. and pg., dates, surveyor; exact description of monument replaced; if location computed, by taped or EDM traverse; landowner remarks, etc. (Use reverse side if necessary)

Set corner on the centerline opposite fence line to the north. this location is very nearly proportionate in the east west direction and is on a line extended of a fence heading east from theNW CORNER of Section 21. This corner also falls very close to original record distances from the south.

ALL OK 4/15/85 DK.

ALL OK 2-8-90 KZ-SS

11 11 2-7-95 JG


ALL OK 2-10-00 TW-SS

 CORNER NO.
 6

 SECTION
 22

 TOWN
 /6

 RANGE
 5

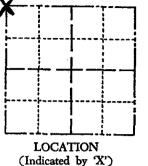



SEAL:




DATA SHOWN HERE ON CERTIFIED CORRECT:

Tree on PR

DATE: 9/4/79

TIE SKETCH

Show at least four ties, also fence lines, roads, topo, size and type of witness trees' and if off road - best way to arrive at corner.

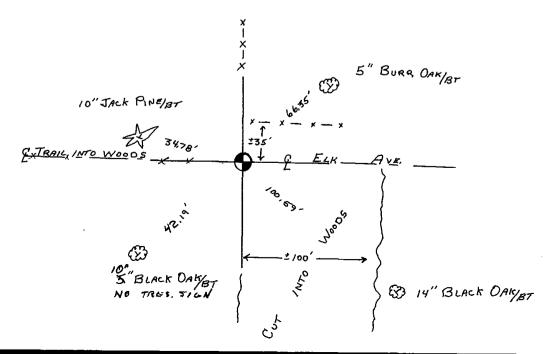

MAINTENANCE RECORD

DATE	BY WHOM	REMARKS
10/3/80	KV-5K	COR OK
2-8-90	Kz-55	ALL PK
2-10-00	T.W. SS	ALL OK
1-20-05	JG-DA	c)
7-7-10	کک	d
<u> </u>		