## O5 RANGE ADAMS COUNTY C

## PUBLIC LAND SURVEY MONUMENT RECORD

**HARRISON** TYPE OF MONUMENT: ADAMS COUNTY COORDINATES, NAD 83 (2007) N. 180587.786 E. 517864.412 **ELEVATION-**DATUM FIELD WORK DATE: 01/22/2021

## BASIS FOR MONUMENT LOCATION

1976 - PLS 1103 RAN EDM/T2 TRAVERSE AROUND SECTION 14 TO DETERMINE SEARCH AREAS FOR INVESTIGATION. FOUND 6" DIAMETER BY 5' LONG POINTED, DRIVEN WOODEN POST WITH BLAZES ON 2 SIDES. THIS POST IS SIMILAR TO THOSE FOUND AT THE EAST QUARTER AND NORTHEAST CORNERS OF THIS SECTION. COULD FIND NO OTHER EVIDENCE OF THE ORIGINAL CORNER, REMONUMENTATION OR ACCESSORIES. REPLACED POST WITH HARRISON ON 11-171976.

2021 - PLS 2675 FOUND A HARRISON MONUMENT 4"± BELOW THE MARSH SURFACE AND 5 WITNESSES. THE MONUMENT AGREES WITH ALL 5 WITNESSES. ACCEPTED THE HARRISON AS THE CORNER LOCATION. SET 4 NEW TIES AND MEASURED TO THE EXISTING WITNESSES.



(INDICATE CORNER BY "X")




DATA SHOWN HERE ON THIS TIE SHEET IS CORRECT AND COMPLETE TO THE BEST OF MY KNOWLEDGE AND BELIEF.

PROFESSIONAL LAND SURVEYOR DATE

- TIE SKETCH



- SET 3/4" x 18" IRON REBAR, 1.50#/FT
- FOUND HARRISON MONUMENT
- STEEL FENCE POST
- VINYL "T" POST
- WITNESS TREE
- LITE METAL POST WITH DND SIGNS

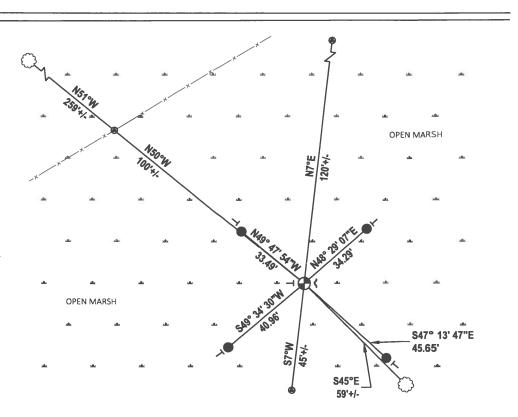

		70
ADAMS COUNTY	CORNER NO	70
Survey Monument Record	SECTION _	14
TYPE OF MONUMENT: Standard Harrison	TOWN _	16
STATE PLANE COORDINATES: N	RANGE _	
ELEVATION — M.S.L. DATUM:		7
THETA ANGLE:		4
FIELD BOOK: PAGE		
	172	N
BASIS FOR MONUMENT LOCATION		
(Use reverse side if necessary)	<u> </u>	
Show info such as: History of corner, with reference to Vol. and pg, dates, surveyor; exact description of monument replaced; if location computed, by taped or EDM traverse; landowner remarks, etc.	LOCĂTION (Indicated by 'X') SEAL:	
Ran EDM/T2 traverse around Section 14 to determine search areas for investigation.	ARTHUR SCOV	Name of the State
Found 6" diameter by 5' long pointed, driven wooden post with blazes on 2 sides. This post similar to those found at the East Quarter and Seatheast corners of this section.  Could find no other evidence of the original corner, remonumentation or accessories.	is DALE C.	
Replaced post with Harrison on 11-17-76.	SUR	Service Control of the Control of th
MON. 4 TIES OF 1/13/81 RN-SK		
" " " " 11-7-85 GR-SS  FOR 1990'S UP DATE NEED TO TAKE MONUMENT  MATERIALS WITH PREF. (STEEL FENCE POST)  OK 1-9-90 KZ-GR  4-NEW, 1-12-06, JG-SS	CERTIFIED CORRECT:  Registered Land Surveyor  DATE:	
TIE SKETCH  (Show at least four ties)  NOTE  Ties in trees to	B.T. IS 6' + W B" TAMARACK A FENCE CORN	SED AS
nail in disc. No other suitable	\	
bearing trees in	\	IN
vicinity.	199.92' STY 8"TO	marack/gz
100'± S.	ROWID 59.01	SURVE SICV
FENCE		
ENTER FROM WEST	4" TAMPRACK	
1"IP FO BENT/BROKEN INSTALL 2'	BT/SIGN	
SECTION IMM. WEST PUT STL POST	- LITE METAL POSTS	
IN A SEC & PLACED IMM. EAST	W/ DND SIGNS	
REVISED 1974		

REVISED 1974