05 ADAMS COUNTY COUNTY

PUBLIC LAND SURVEY MONUMENT RECORD

HARRISON TYPE OF MONUMENT: ADAMS COUNTY COORDINATES, NAD 83 (2007)

N. 180595.159

E. 520605.174

ELEVATION-DATUM_

01/19/2021 FIELD WORK DATE:


BASIS FOR MONUMENT LOCATION

1976 - PLS 1103 RAN EDM/T2 TRAVERSE AROUND SECTION 14 TO DETERMINE SEARCH AREAS FOR INVESTIGATION. FOUND 6" DIAMETER BY 5' LONG WOODEN POST, BLAZED ON SIDES, WITH POINTED BOTTOM DRIVEN IN SWAMP. THIS POST IS SIMILAR TO THOSE FOUND AT THE SOUTH AND EAST QUARTER CORNERS OF THIS SECTION. COULD FIND NO EVIDENCE OF THE ORIGINAL BEARING TREES, OR SUBSEQUENT REMONUMENTATION OTHER THAN POST. REPLACED POST WITH HARRISON OF 11-17-1976.

2021 - PLS 2675 FOUND A HARRISON MONUMENT 2"± BELOW THE MARSH SURFACE AND DID NOT RECOVER ANY EXISTING TIES OR WITNESSES. ACCEPTED THE HARRISON AS THE CORNER LOCATION. SET 4 NEW TIES.



(INDICATE CORNER BY "X")

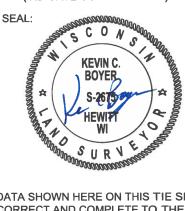


DATA SHOWN HERE ON THIS TIE SHEET IS CORRECT AND COMPLETE TO THE BEST OF MY KNOWLEDGE AND BELIEF.

PROFESSIONAL LAND SURVEYOR

2021

- TIE SKETCH



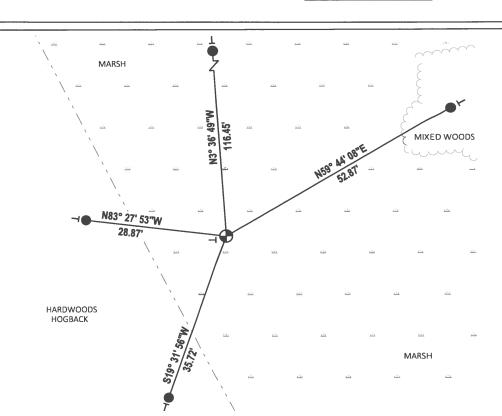

- SET 3/4" x 18" IRON REBAR, 1.50#/FT
- FOUND HARRISON MONUMENT
- VINYL "T" POST

CORNER NO. _ ADAMS COUNTY SECTION Survey Monument Record TYPE OF MONUMENT: Standard Harrison TOWN STATE PLANE COORDINATES: N 43°51'43.3" RANGE HAND HELD & PS R 089°51'268" ELEVATION - M.S.L. DATUM: THETA ANGLE: . PAGE _70 FIELD BOOK: _ BASIS FOR MONUMENT LOCATION (Use reverse side if necessary) LOCATION Show info such as: History of corner, with reference to Vol. and pg, dates, surveyor; exact description of monument replaced; if location computed, by taped or EDM traverse; landowner (Indicated by 'X') SEAL: ANIMISCONS ANIMA Ran EDM/T2 traverse around Section 14 to determine search areas for investigation. Found 6" Diameter by 5' long wooden post, blazed on sides, DALE C. with pointed bottom driven in swamp. This HAGEN S-1103 post is similar to those found at the South Wiscensin Rapids, and East Quarter corners of this section. Could find no evidence of the original bearing trees, or subsequent remonumentation other than post. Replaced post with Harrison on 11-17-76. 1-9-81 TH-NJ MON OK CERTIFIED CORRECT 2-14-85 1-9-90 GR DK Registered Land Surveyor DATE: 11-30-76 SEE CARLSON 7-13-90 NEXT PAGE 1-CONE 1-NEW 12-20-05, -JG 12-09-10 GR- OK DATE: TIE SKETCH WHITE (Show at least four ties) NOTE: Ties in trees to nail in disc. No other bearing trees are available. WITH DND SIGN OK -"CONE 05" 7-Pas7

GREEN METAL POST

DNO SIGN

8"Burr Oak By

MAPLE