## OS RANGE ADAMS COUNTY C


## PUBLIC LAND SURVEY MONUMENT RECORD

**HARRISON** TYPE OF MONUMENT: ADAMS COUNTY COORDINATES, NAD 83 (2007) N. 177981.319 E. 509929.338 **ELEVATION-**DATUM FIELD WORK DATE:\_\_\_ 02/03/2021


## **BASIS FOR MONUMENT LOCATION**

1979 - PLS 1478 SET CORNER EQUIDISTANT AND ON LINE BETWEEN ADJACENT SECTION CORNERS. SEARCH OF THE AREA YIELDED NO EVIDENCE OF ANY PREVIOUS MONUMENTATION.

2021 - PLS 2675 FOUND HARRISON MONUMENT FLUSH WITH THE MARSH AND 3 WITNESS TREES. THE MONUMENT AGREES WITH ALL 3 WITNESS TREES. ACCEPTED THE HARRISON AS THE CORNER LOCATION. SET 4 NEW TIES AND MEASURED TO THE WITNESS TREES.

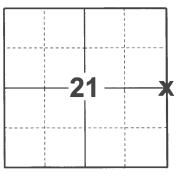


**LOCATION** (INDICATE CORNER BY "X")

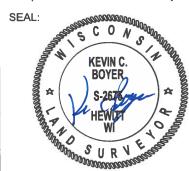

DATA SHOWN HERE ON THIS TIE SHEET IS CORRECT AND COMPLETE TO THE BEST OF MY KNOWLEDGE AND BELIEF.

PROFESSIONAL LAND SURVEYOR

2/23/2001

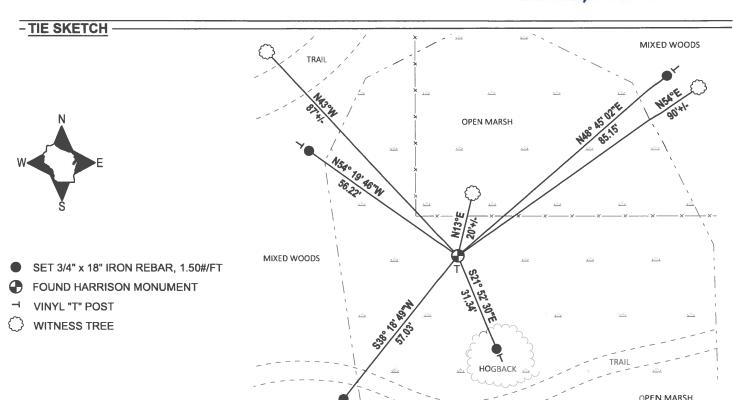

Government Land Corner	Certificate			
ADAMS	Commercia		CORNER NO	77
TYPE OF MONUMENT: HARRISON	County		SECTION _	2/
STATE PLANE COORDINATES: N			TOWN _	16
			RANGE _	
ELEVATION — M.S.L. DATUM:		<del> </del>	· - <del>!   </del>	_
THETA ANGLE:  FIELD BOOK: 54 PA		[		! 4
DRAWN BY:				4
			++	* N
BASIS FOR MONUMENT LOCATION	J			
Show info such as: History of corner, with refer	ence to Vol.	į		Í
and pg., dates, surveyor; exact description of replaced; if location computed, by taped or EI landowner remarks, etc. (Use reverse side if ne	monument	<u> </u>	LOCATION	
•	**	CEAI.	Indicated by 'X')	
Set corner equidistant and on 1	ine between adjac	ent section corr	ners.	
Search of the area yielded no e monumentation.	vidence of any pr	evious	WINGCONS	1111
		and a	MISCONS	V May
			GREGORY P. RHINEHART S-1478 Wisconsin Rapid Wis.	THE THE PARTY OF T
		88	RHINEHART S-1478	}
			Wisconsin Rapid Wis.	s / <b>3</b>
			\	A. S.
		300	AND SURVE	don't
			SUR	100
•		DATA SHO CERTIFIED	WN HERE ON	•
		Mag		
	•	Registered I	ind Surveyor	,
		DATE:	9/4/	179
				<del></del>
TIE SKETCH		9? 6" ASPEN/B	ア	
Show at least four ties, also fence lines, roads, t and type of witness trees' and if off road - bes	opo, size : way to	7~	•	
arrive at corner.	*	b 2010		
ENTER FROM NORTH FOLLOW EAST OF MARSH - PIND NEW	PIDGE TREE	SO IO'ELM :	10.0 DTH	
FENCE AT 13201' FOLLOW	$\overline{\mu}$	\$ tho	~ / / /	
FERCE WEST, FIND OLD FEN CORNER NEAR MIDDLE	ee / X		"JACK PINE	
OF MARSHY AREA 111	3 1210	100 XX	OK BT	
FOLLOW FENCE SOUTH TO ARRIVE AT CORNER .	08"EZM X" 286.5'	40.20	_	
TO ARRIVE AT CORNER ,,  BRUSHED UPE VISIBLE !	-N 45 W	1x _ x _ v _ x	LINE	5" ASPENIET
10' EAST OF FENCE FOR SOUTHERLY 1000'+	2010 'X-	±10'		5 HSPENIBT
11		7	121.68'	<b>(D)</b>
To d' A TO PLACE THE	<u> </u>	7,50		111
To 3/4" ALUM. PIPE	30.	7-		
y 17.00 0 7.	X 94	T STUB		
A	ALE X	(DEAD) Sign	<u>.</u>	
670	SMAPLE	<u> </u>		
1.0	46.3' ±540°E			
	2010		1	

## MAINTENANCE RECORD

DATE	BY WHOM	REMARKS
10/13/80	KV-JK	COR. OK
11-5-85	SORENSEN	Au O.K.
2-8-90	55	I NEW TIE TO JACKPINE .
3-3-05	<u> </u>	ALL OK
12-10-10	S <b>S</b>	3 NEW TIES